



STEEL BUILDINGS

WHO CAN? TOTALSPAN!

SPECIFIC DESIGN

Gable Range

**Producer Statement and Structural Details
(IL2, Habitable, Lined*, Closed)**

CLIENT:

Nathan Tritt
300 Homewood Road
Otane
4277

BUILDING:

TRS Project Ref: 1550193
Location: Lat: -39.935776 Lng: 176.6435971
Wind Speed: Vdes Θ : 40.95 m/s
Snow Loading: Sg = None
Span: 7.000m
Length: 12.000m
Knee Height: 2.700m
Bay Size: 2x6.000m
Roof Details: 15° pitch, 7 Rib 0.35mm
Cladding Details: 7 Rib 0.35mm
Downpipe Size: 80mm Dia PVC
Floor Type: Concrete Slab (No Calculations)
Area: 84.000m²

NOTES :

- 1 - Contractor to confirm all dimensions on site at time of construction
- 2 - These drawings must not be reproduced without express permission from Spanbild New Zealand Limited.

INDEX:

- 1 Contents
- 2 Producer Statement / Specifications
- 3 Durability Statement
- 4 Site Plan
- 5-8 Engineering Tables
- 9 Foundation Details SD-F01
- 10 Foundation Details SD-F02
- 11 Foundation Details SD-F05.1
- 12 Frame Details SD-P01
- 13 Frame Details SD-P03
- 14 Frame Details SD-A01
- 15 Frame Details SD-A02
- 16 Major Openings SD-M01
- 17 Minor Door Openings SD-M05
- 18 Minor Window Openings SD-M06
- 19 Flashing Details
- 20 Flashing Detail SD-E01

APPROVED
BC210007
22/02/2021
Andrew Nichols
Page 1 of 34
Central Hawkes Bay
District Council

***Bay 2 only to be lined with GIB on walls and ceiling.
All other walls to be lined with R-board, with bridging
at 1350 crs as per R-Board specifications.**

TOTALSPAN

A Division of Spanbild New Zealand Ltd
112 Waterloo Road, Hornby
P.O.Box 11-013, Christchurch Details



Gable Range - Design

Contents

Sheet 1 of 20



Building Code Clause(s) **B1**

PRODUCER STATEMENT - PS1 - DESIGN

(Guidance on use of Producer Statements (formerly page 2) is available at www.engineeringnz.org)

ISSUED BY: **Calibre Consulting Ltd**
(Design Firm)

TO: **Totalspan Hawke's Bay**
(Owner/Developer)

TO BE SUPPLIED TO: **Central Hawke's Bay District Council**
(Building Consent Authority)

IN RESPECT OF: **7m span x 12m IL2 Habitable, Unlined portal building; DL=50yrs**
(Description of Building Work)

AT: **300 Homewood Road, Otane, 4277, New Zealand**
(Address)

LOT: **2** DP: **344960** SO:

We have been engaged by the owner/developer referred to above to provide **Structural Design**

.....

.....
(Extent of Engagement)

services in respect of the requirements of Clause(s) **B1** of the Building Code for:

☒ All or ☐ Part only (as specified in the attachment to this statement), of the proposed building work.

The design carried out by us has been prepared in accordance with:

☒ Compliance Documents issued by the Ministry of Business, Innovation & Employment **B1/VM1, B1/VM4** or
(verification method / acceptable solution)

☐ Alternative solution as per the attached schedule.....

The proposed building work covered by this producer statement is described on the drawings titled

Gable Range and numbered **Sheets 1-2, 5-18**;
together with the specification, and other documents set out in the schedule attached to this statement.

On behalf of the Design Firm, and subject to:

(i) Site verification of the following design assumptions: **good ground as per NZS3604, with UBC reduced to 225kPa.**

(ii) All proprietary products meeting their performance specification requirements;

I believe on reasonable grounds that a) the building, if constructed in accordance with the drawings, specifications, and other documents provided or listed in the attached schedule, will comply with the relevant provisions of the Building Code and that b), the persons who have undertaken the design have the necessary competency to do so. I also recommend

the following level of construction monitoring/observation:-

☐ CM1 ☐ CM2 ☐ CM3 ☐ CM4 ☐ CM5 (Engineering Categories) Of ☐ as per agreement with owner/developer (Architectural)

I, **John McCurran** am: ☒ CPEng **48451** # ☐ Reg Arch #
(Name of Design Professional)

I am a member of: ☒ Engineering New Zealand ☐ NZIA and hold the following qualifications: **BE (civil)**

The Design Firm issuing this statement holds a current policy of Professional Indemnity Insurance no less than \$200,000*

The Design Firm is a member of ACENZ: ☒

SIGNED BY **John McCurran** (Signature)

ON BEHALF OF **Calibre Consulting Ltd** Date **18 January 2021**
(Design Firm)

Note: This statement shall only be relied upon by the Building Consent Authority named above. Liability under this statement accrues to the Design Firm only. The total maximum amount of damages payable arising from this statement and all other statements provided to the Building Consent Authority in relation to this building work, whether in contract, tort or otherwise (including negligence), is limited to the sum of \$200,000*.

This form is to accompany **Form 2 of the Building (Forms) Regulations 2004** for the application of a Building Consent.
THIS FORM AND ITS CONDITIONS ARE COPYRIGHT TO ACENZ, ENGINEERING NEW ZEALAND AND NZIA

SPECIFICATIONS

GENERAL NOTES

IMPORTANT DESIGN LIMITATIONS

1.1. Design limitations apply to any item or alteration not specifically stated or clearly represented within the scope of these engineering specifications.

This is a CAD drawing which must not be altered by manual methods, exceptions to this are:

- 1.1.1. The documentation clearly states where "generic" items can be crossed out, or the applicable detail circled to provide clarity.
- 1.1.2. Additional specific design has been carried out by a CPENG engineer with a PS1 supplied covering "part" design works for any amendment/alterations. Alternative/Additional drawings shall be supplied or these specifications must be clearly marked up in red pen and accompanied by the PS1 engineer's signature on each drawing altered which is covered by the additional specific design, as above.
- 1.1.3. A letter has been supplied in writing, signed by the original engineer(s) covering "minor" amendments/alterations or clarifications to varying interpretations of the design drawings.

~~1.2. Habitable/Lined Buildings are not covered within this scope of work.~~

2. GENERAL

- 2.1. All work shall conform to the New Zealand Building Code
- 2.2. B2 Durability shall be covered by respective product/manufacturers durability statements

3. LOADINGS

- 3.1. Buildings are designed to AS/NZS 1170
- 3.1.1. Refer Schedule for Windspeed, V_{des0} in m/s.
- 3.1.2. Refer Schedule for Ground Snow Load if applicable in kPa.
- 3.1.3. The roofing is not designed for point loads of 1.1kN, these are Surfaces (including transparent surface) over which supports (e.g., boards or ladders) are required to be laid to support actions incidental to maintenance (e.g., people).
- 3.1.4. Earthquake loads, except for "near fault" locations due to the light-weight structure are not critical for unlined, Importance Level 1 & 2 standard structures with cladding as specified below only.
- 3.1.5. Habitable/Lined or Importance Level 3 and greater structures require specific design engineering in addition to this specification covering the scope of works. (Importance Level 2 structures have been designed to resist "structural damage" deflections only).
- 3.1.6. Any loads exceeding the above shall require specific design engineering in addition to this specification covering the scope of works.

4. FOUNDATIONS

- 4.1. Ground shall have a safe bearing capacity of at least 75kPa (225kPa Ultimate).
- 4.1.1. This is achieved by meeting "good ground", safe bearing capacity of at least 100kPa in accordance with NZS 3604 (i.e. exceeds the above) OR;
- 4.1.2. Safe bearing capacity of at least 75kPa by Site Specific Geo-Technical Report (as NZS 3604 has no means of determining a minimum safe bearing of 75kPa).

5. CONCRETE

- 5.1. Designed to NZS 3101
- 5.2. Remove vegetation and loose material from the building footprint, backfill with compacted hard-fill if required and lay sand blinding to the underside of the concrete slab. Ensure the surface of the slab will be at least 100mm above the highest level of cleared ground around the slab.
- 5.3. Concrete shall have a maximum aggregate size of 20mm and minimum 20MPa compression strength at 28 days.
- 5.4. Refer Foundation Details for further details.
- 5.5. Lesser Ductile Mesh is allowed to be used for Importance Level 1 structures only
- 5.5.1. Refer NZS 3101 Clause 5.3.2.7 (a)

6. STEELWORK & COMPONENTS

- 6.1. All Steelwork & Components shall (where applicable) conform to:
 - 6.1.1. AS/NZS 4600 - Cold-formed steel structures
 - 6.1.2. AS/NZS 1252 - High strength steel bolts with associated nuts and ...
 - 6.1.3. AS/NZS 1365 - Tolerances for flat-rolled steel products
 - 6.1.4. AS/NZS 4505:2013 - Garage doors and other large access doors
 - 6.1.5. AS 1110 - ISO metric hexagon bolts and screws
 - 6.1.6. AS 1112 - ISO metric hexagon nuts...
 - 6.1.7. AS 1397 - Continuous hot-dip metallic coated steel sheet and strip
 - 6.1.8. AS 1580 - Paints and related materials - Methods of test
 - 6.1.9. AS 3566 - Self-drilling screws for the building and construction industries
 - 6.1.10. and ...
 - 6.1.11. IFI-114(Imperial) / IFI-505(Metric) - Break Mandrel Blind Rivets

7. CLADDING

- 7.1. Steel only. Alternative claddings (excluding glass reinforced panel), require an independent specific design certificate for the scope of work.
- 7.2. Fixing pattern as per E2/AS1 or NZ MRM - NZ Metal Roof and Wall Cladding Code of Practice.
- 7.3. Flashings shall be fixed as per manufacturers recommendations/instructions.

8. SERVICES

- 8.1. Penetrations through framing members
 - 8.1.1. Typical hole diameter(s) shall not exceed 29mm (1 1/8 inch)
 - 8.1.1.1. A single 44mm (1 3/4 inch) hole per C150, C250 or C300 section only is allowed to accommodate an up to 40mm waste water pipe
 - 8.1.2. Distance between holes along the section shall be no less than 1000mm
 - 8.1.3. Holes shall be located:
 - 8.1.3.1. Central in the web, (within the centre 1/3 of the web depth)
 - 8.1.3.2. At least 200mm from the end of a member
 - 8.1.4. Rubber grommets to be applied to un-swaged service holes
 - 8.1.5. Larger and more frequently spaced holes are allowed, however please consult with an engineer first for written approval to ensure compliance with AS/NZS 4600.

Project Ref: 1550193
© Copyright 2017 Spanbild NZ Ltd. All rights reserved.

Nathan Tritt
300 Homewood Road
Otane 4277
0272031205

Gable Range - Design

Producer Statement / Specifications

Sheet 2 of 20

MANUFACTURERS STATEMENT - DURABILITY

Cladding

To satisfy the requirements of Clause B2: "Durability" of the NZBC and to ensure the cladding material meets a 15-year durability life and a 50 year intended working life (design life), the following provisions must apply:

Cladding Range of Product and Use

- Coating Type: Zinc/Aluminium & Painted (Coloured Steel).
- Steel thickness range: 0.35mm - 0.55mm BMT
- Steel grade range: G300 - G550
- Application: Standard Totalspan Roof and Wall Cladding
- Profile: Totalspan 7 Rib, Totalspan 6 Rib, Totalspan Corrugate

Requirements, Limitations and Exclusions

- Fixing and installation of the cladding must be done exactly in accordance with Totalspan Buildings instructions and specifications.
- Normal and regular maintenance must be carried out on the exterior surface of the cladding and the following guide must be followed to ensure the durability requirements are met.

Regular Maintenance

- Normal Maintenance to be completed in accordance with Durability - Acceptable Solution B2/AS 2.1.3
- Corrosion Zones B and C.. (*Reference NZS 3604:2011 Corrosion Zone Figure 4.2)
Rain-washing only required on exposed (open to airborne salts and rain wetting) material. Sheltered (open to airborne salts, but not rain washed) or protected areas such as under spouting, top-cladding sheets and tops of doors require washing every 3 months.
- Sea Spray Zone D (Includes all off-shore islands, the area within 500m of the coastline of New Zealand, and those areas shown in white - *Reference NZS 3604:2011 Figure 4.2) and areas of Geothermal Activity (*Reference NZS 3604:2011 4.2.4 (c)).
Rain-washing only required on exposed (open to airborne salts and rain wetting) areas. Sheltered (open to airborne salts, but not rain washed) and protected areas such as under spouting, top cladding and tops of doors require washing down every month and whenever corrosive salts are present.

Extended Maintenance, Painting or Repainting

Extended Durability

Once the metallic coating or the paint system has weathered away, signs of red rust for bare material or signs of the metallic coating for painted material, painting of the entire surface is required to extend the life of the product. Paint manufacturers recommendations are to be followed for surface preparation and paint type to be used.

Evident Corrosion

- Areas that show signs of white or red rust/corrosion (typically in unwashed areas) require cleaning back with a stiff brush and cleaner to remove all dust, surface contaminants and corrosion products and present a sound substrate for painting. Priming of the surface and application of two coats of paint as per the Paint Manufacturer's recommendations is then required.
- Particular attention needs to be paid to laps (side, end, flashing etc) where earlier corrosion may start due to moisture and dirt entrapment.
If evident corrosion is not treated quickly rapid deterioration of the sheet may occur which could result in perforation. At this stage replacement of the affected sheet is the best option.

Steel Framing

To satisfy the requirements of Clause B2: "Durability" of the NZBC and to ensure the structural framing material meets a 50-year durability life the following provisions must apply:

Steel Framing Range of Product and Use

- Coating Type: Galvanised
- Steel thickness range: 0.75mm – 2.4mm BMT
- Steel grade range: G450 – G550
- Application: Standard Totalspan Purlins, Girts, Portal Frames, Door Jambs, Wall Uprights, Bridging
- Profile: C Sections – 80x40, 150x64, 220x64, 250x85
Z Sections – 100x53, 150x65
Tophat Sections – 100x163, 120x170, 150x183

Awnings/Garaports attached to Base Buildings

- Where sections are exposed to or located in salt marine, corrosive industrial or unusually high corrosive environments the below Regular Maintenance must be adhered to.
Please contact the manufacturer for specialist advice if unsure of requirements. This also applies to all Steelwork that is exposed to the wind but is protected from the rain located in an open sided structure such as carports, awnings or structures closed in on one side only.
Maintenance is necessary when the Galvanised coating ceases to provide sacrificial protection to the steel base, or where the appearance is no longer aesthetically acceptable. Rust staining or the growth of rust spots usually indicates the breakdown of Galvanised coating. At the first sign of breakdown, the surface should be treated with an appropriate maintenance coating system. All maintenance should be carried out in accordance with AS/NZS 2312: 2002 (Incorporating Amendment No. 1) [c] and New Zealand Steelwork Corrosion Coatings Guide (HERA Report R4-133) [d].

Regular inspections of the steel work and maintenance at the first signs of a problem will extend the durability of the sections. If any of the structure components show signs of corrosion during normal maintenance these are also easily accessible and simple to replace.

Regular Maintenance

- Normal Maintenance to be completed in accordance with Durability - Acceptable Solution B2/AS 2.1.3 Corrosion Zones B and C. (*Reference NZS 3604:2011 Corrosion Zone Figure 4.2)
Rain-washing only required on exposed (open to airborne salts and rain wetting) material.
Sheltered (open to airborne salts, but not rain washed) or protected areas such as under spouting, top-cladding sheets and tops of doors require washing every 3 months.
- Sea Spray Zone D (Includes all off-shore islands, the area within 500m of the coastline of New Zealand, and those areas shown in white - *Reference NZS 3604:2011 Figure 4.2) and areas of Geothermal Activity (*Reference NZS 3604:2011 4.2.4 (c)).
Rain-washing only required on exposed (open to airborne salts and rain wetting) areas
Sheltered (open to airborne salts, but not rain washed) and protected areas such as under spouting, top cladding and tops of doors require washing down every month and whenever corrosive salts are present.

References

1. NZBC – Compliance Document – Clause B2 - Durability
2. NZS 3604, Clause 4, Durability*

* - Totalspan Buildings acknowledges and understands that NZS 3604 is a Timber Framed Building standard. Totalspan Buildings has used NZS 3604 as a reference only to identify Corrosion Zones, Sea Spray Zones and areas of Thermal activity.

Totalspan Buildings
112 Waterloo Rd
Sockburn
CHRISTCHURCH

APPROVED
BC210007
22/02/2021
Andrew Nichols
Page 3 of 34
Central Hawkes Bay
District Council

TOTALSPAN®

STEEL BUILDINGS

Project Ref: 1550193

© Copyright 2017 Spanbild NZ Ltd. All rights reserved.


Nathan Tritt
300 Homewood Road
Otane 4277
0272031205

Gable Range

Durability Statement

Sheet 3 of 20


ROOF - (BAYS 2-1)

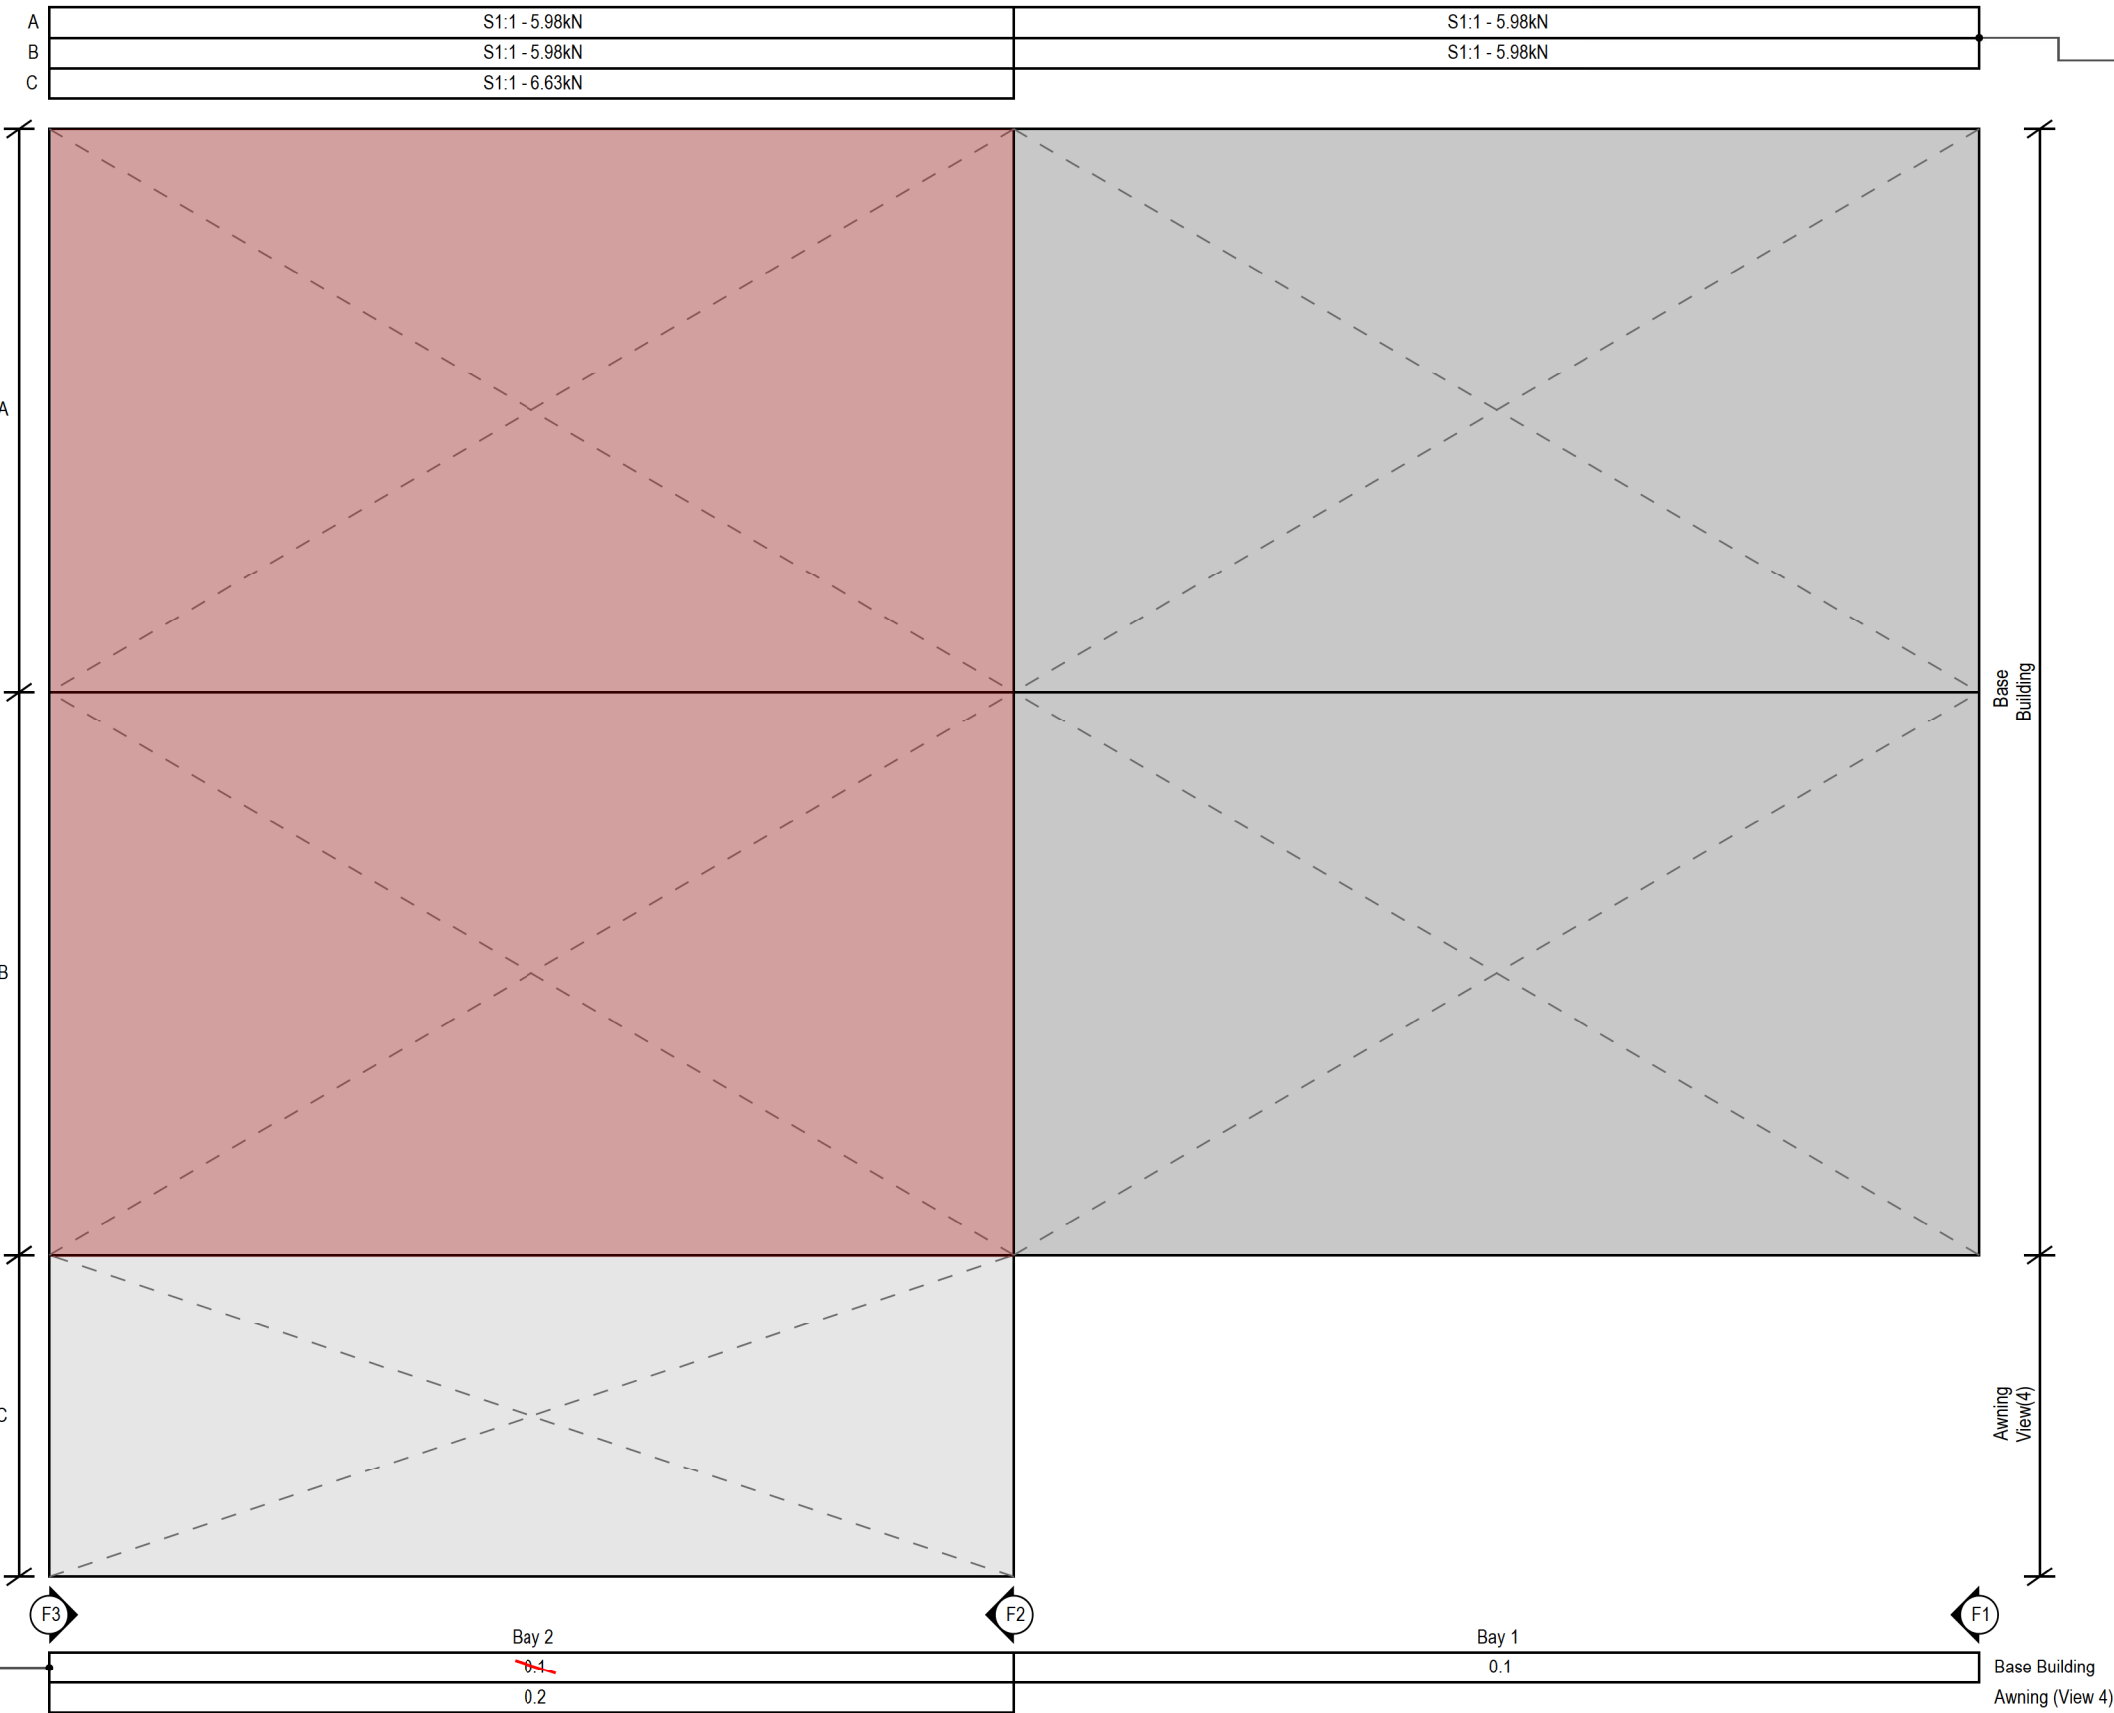

BRACING kN (Totals)		
Location	Required	Achieved
A	8.16 kN	11.97 kN
B	2.46 kN	11.97 kN
C	1.00 kN	6.63 kN

APPROVED
BC210007
22/02/2021
Andrew Nichols
Page 4 of 34
Central Hawkes Bay
District Council

BRACING DESIGN NOTES	
All bracing must be connected to main structural members i.e. Portal Legs, Portal Rafters, End Wall, Uprights & Main Access Door Jambs. Bracing shall not be solely connected to intermediate members such as Girts, Purlins, Minor Access Door Jambs & PA Door Jambs.	
BRACING LEGENDS	
S1:1 Mitek Strip-Brace 27x0.6mm G550, configured as a single cross.	

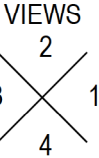


Project Ref: 1550193
© Copyright 2017 Spanbild NZ Ltd. All rights reserved.

Nathan Tritt
300 Homewood Road
Otane 4277
0272031205

Gable Range - Design
Engineering Tables
Sheet 5 of 20


VIEW 2 - BUILDING SIDE (BAYS 1-2)

PROVIDE BRIDGING AT MAX 1350 CRS ON ALL R BOARD LINED WALLS.

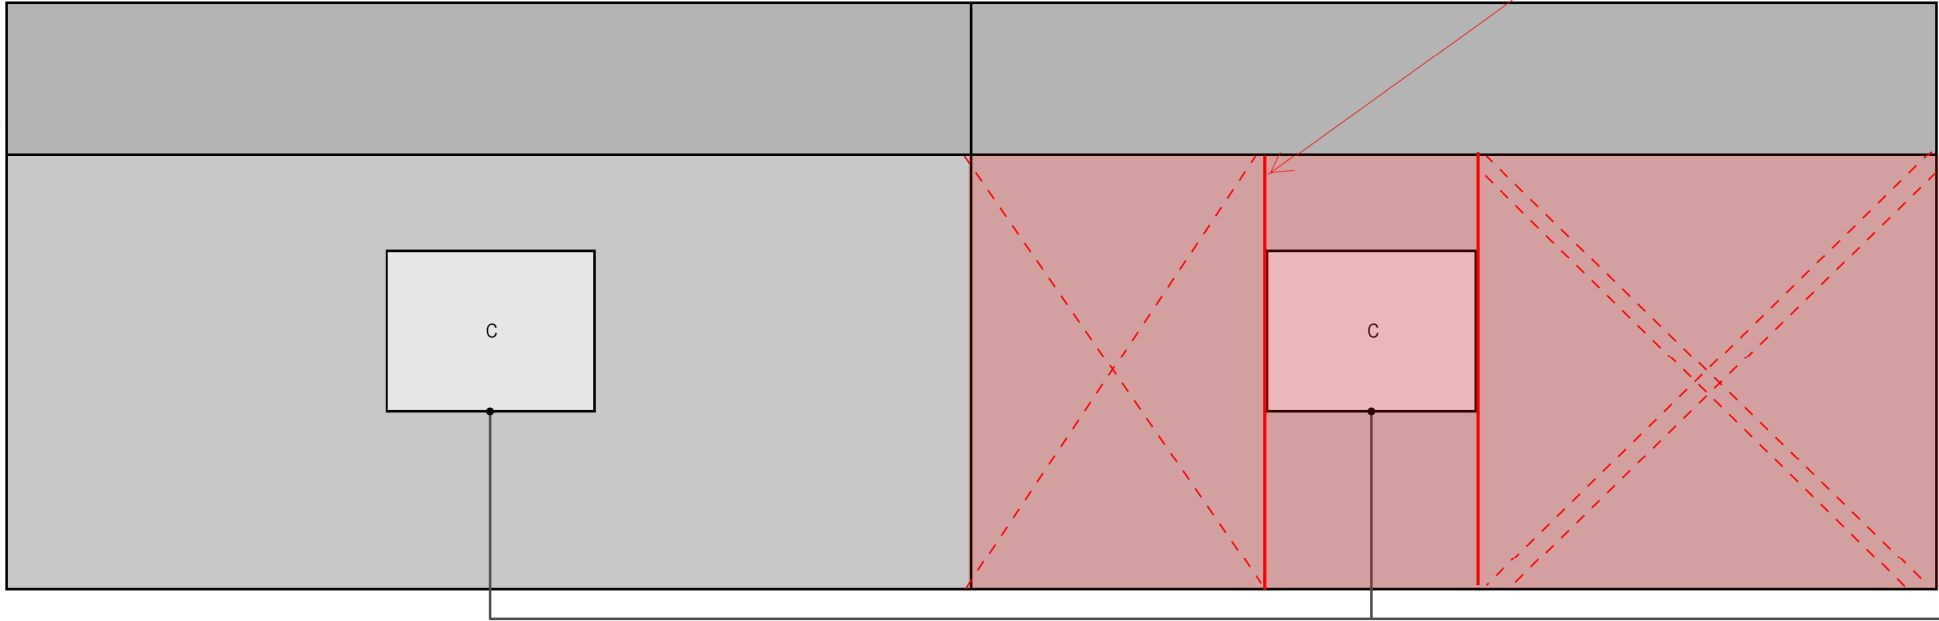

BAY 2 LINED WITH GIB, GIRTS TO BE C80-75(1) AT 600 CRS.

FRAMING SECTION TABLES	
Base Building - 2.1	
Design	Closed
Girt (Bridge Count)	C100-15(2)
Girt Centres	0.600m

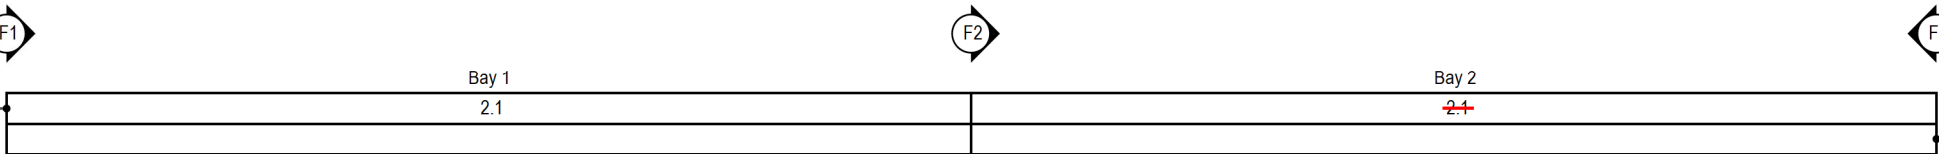


OPENING SECTION TABLES	
Opening - C	
Jambs & Head Beam	C100-15

BRACING kN (Totals)	
Required	11.75 kN
Achieved (Failed)	12.50 kN
Transferred to Opposite Wall	5.31 kN


VIEW 4 - BUILDING SIDE (BAYS 2-1)

EXTEND C10015 JAMBS FROM SLAB TO KNEE HEIGHT.

BAY 2 LINED WITH GIB, GIRTS TO BE C80-75(1) AT 600 CRS.

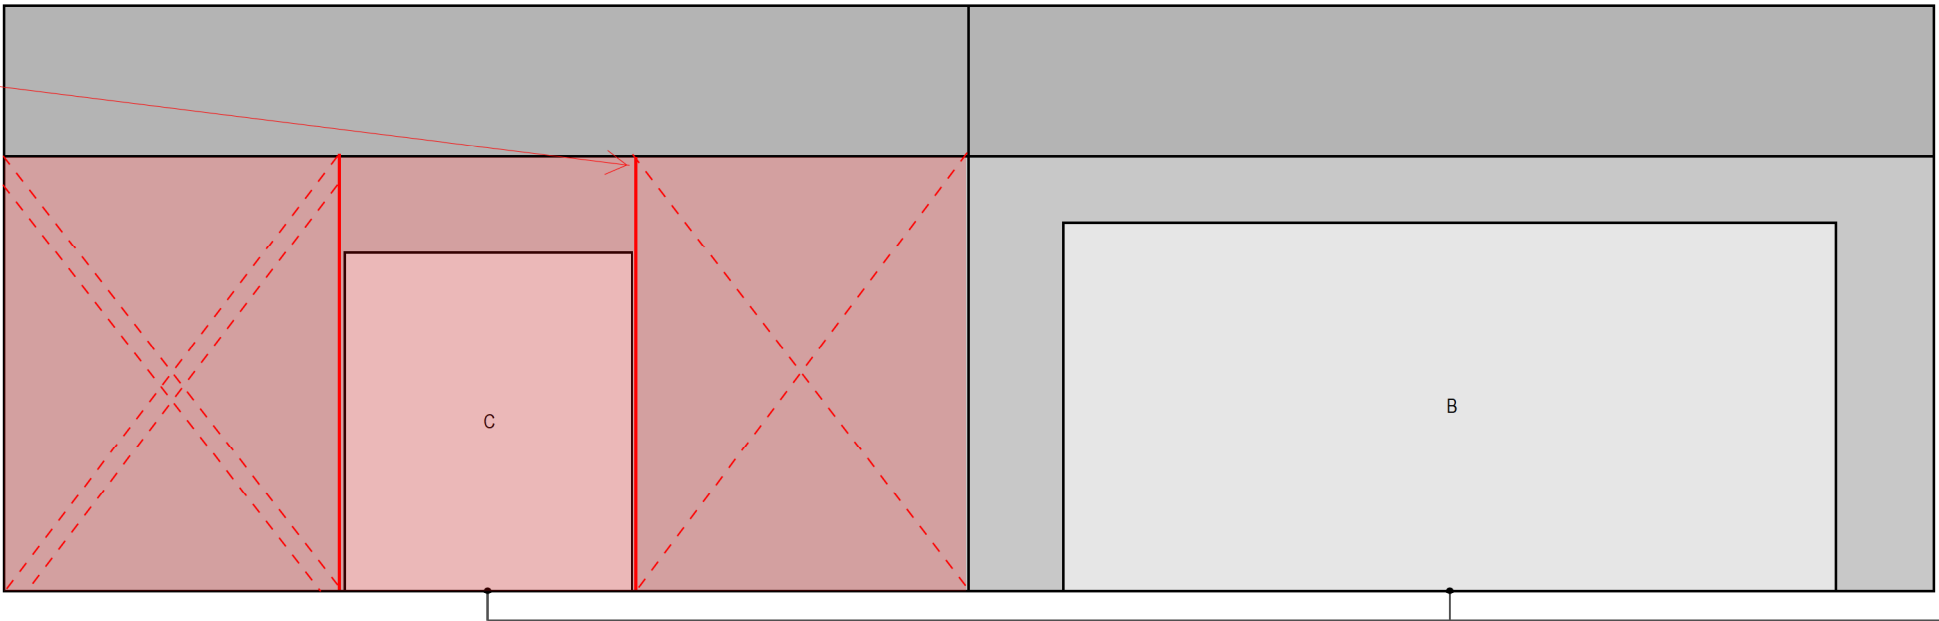


FRAMING SECTION TABLES	
Base Building - 4.1	
Design	Closed
Girt (Bridge Count)	C100-15(2)
Girt Centres	0.600m

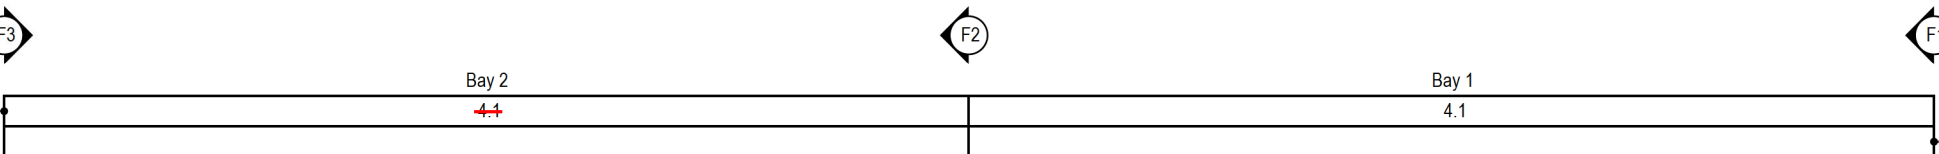

OPENING SECTION TABLES	
Opening - B	
Jambs	B150-10
Head Beam	B150-10
Opening - C	
Jambs & Head Beam	C100-15

BRACING kN (Totals)	
Required	11.75 kN
Achieved	12.50 kN
Transferred to Opposite Wall	5.31 kN

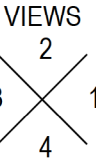

APPROVED
BC210007
22/02/2021
Andrew Nichols
Page 5 of 34
Central Hawkes Bay
District Council




Project Ref: 1550193
© Copyright 2017 Spanbild NZ Ltd. All rights reserved.

Nathan Tritt
300 Homewood Road
Otane 4277
0272031205

Gable Range - Design
Engineering Tables
Sheet 6 of 20

FRAME F1

PROVIDE BRIDGING AT MAX 1350
CRS ON ALL R BOARD LINED WALLS.

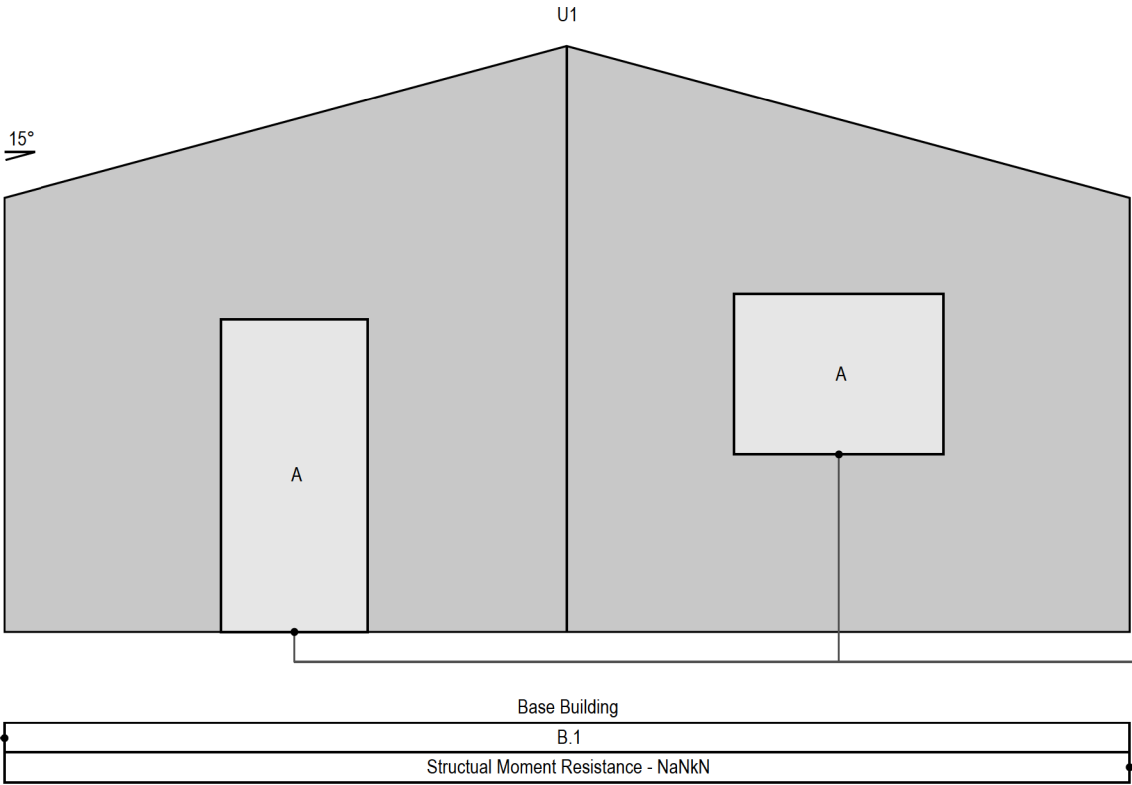


APPROVED
BC210007
22/02/2021
Andrew Nichols
Page 6 of 34
Central Hawkes Bay
District Council

FRAMING SECTION TABLES	
Base Building - B.1	
Design	Closed
Leg & Rafter	C250-19
Upright - U1	C150-12
Girt (Bridge Count)	C80-75(1)
Girt Centres	0.600m

OPENING SECTION TABLES	
Opening - A	
Jambs & Head Beam	C80-95
Upper Support Girt	B80-75(1)
BRACING kN	
Required	NaN kN
Achieved	NaN kN

FRAME F2

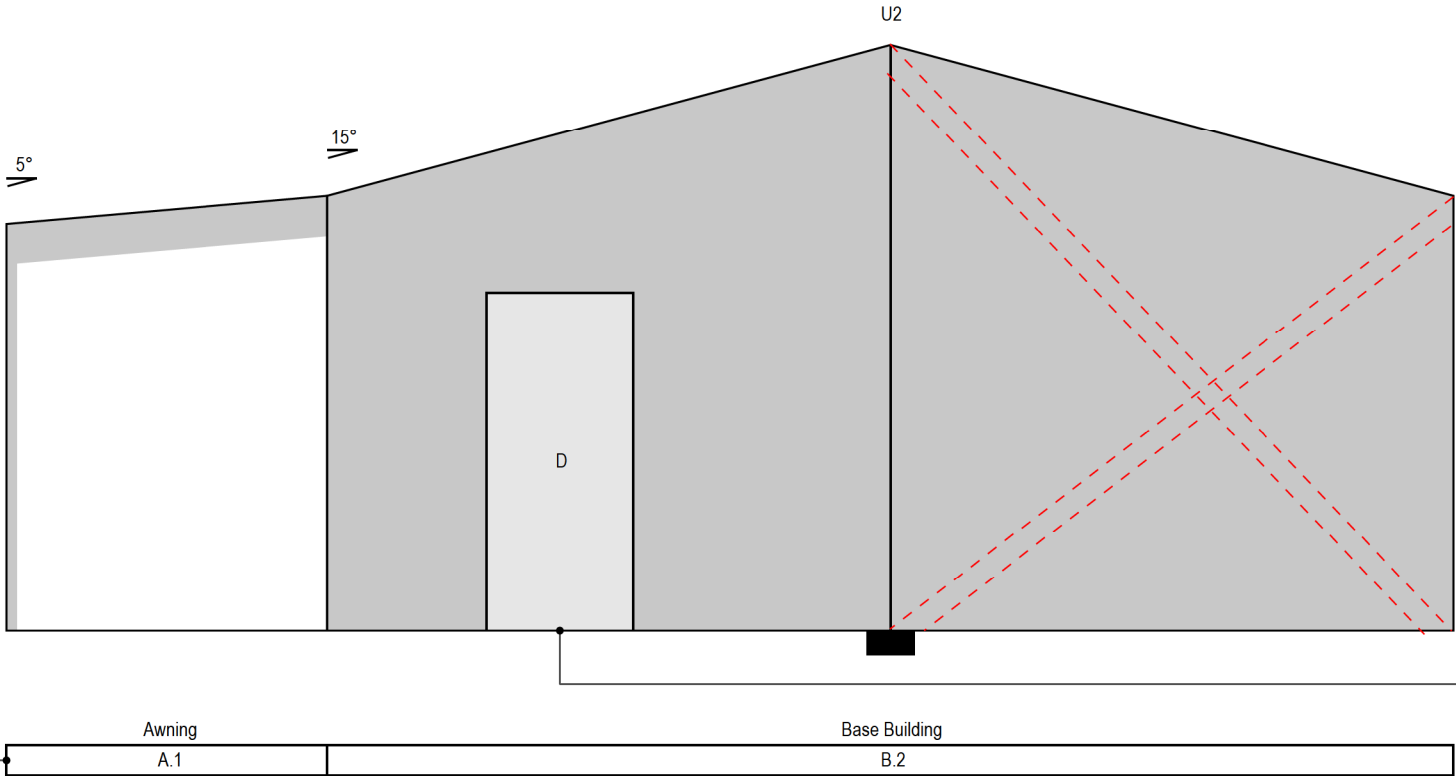


Slab Strengthening, refer to sheet titled
Foundation Details SD-F05.1

FRAME 2 LINED WITH GIB
ON BAY 2 SIDE ONLY.

FRAMING SECTION TABLES	
Base Building - B.2	
Design	Closed
Leg & Rafter	C250-19
Upright - U2	C100-15
Girt (Bridge Count)	C80-75
Girt Centres	0.600m
Awning - A.1	
Design	Open
Rafter	C250-15
Post	SHS65-16

OPENING SECTION TABLES	
Opening - D	
Jambs & Head Beam	C80-75
Upper Support Girt	B80-75(1)

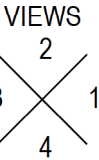

Project Ref: 1550193
© Copyright 2017 Spanbild NZ Ltd. All rights reserved.

Nathan Tritt
300 Homewood Road
Otane 4277
0272031205


Gable Range - Design
Engineering Tables
Sheet 7 of 20

FRAME F3

PROVIDE BRIDGING AT MAX 1350
CRS ON ALL R BOARD LINED WALLS.


FRAME 3 LINED WITH GIB.

FRAMING SECTION TABLES	
Base Building - B.1	
Design	Closed
Leg & Rafter	C150-19
Upright - U1	C150-10
Girt (Bridge Count)	C80-75
Girt Centres	0.600m
Awning - A.2	
Design	Open
Rafter	C150-10
Post	SHS65-16

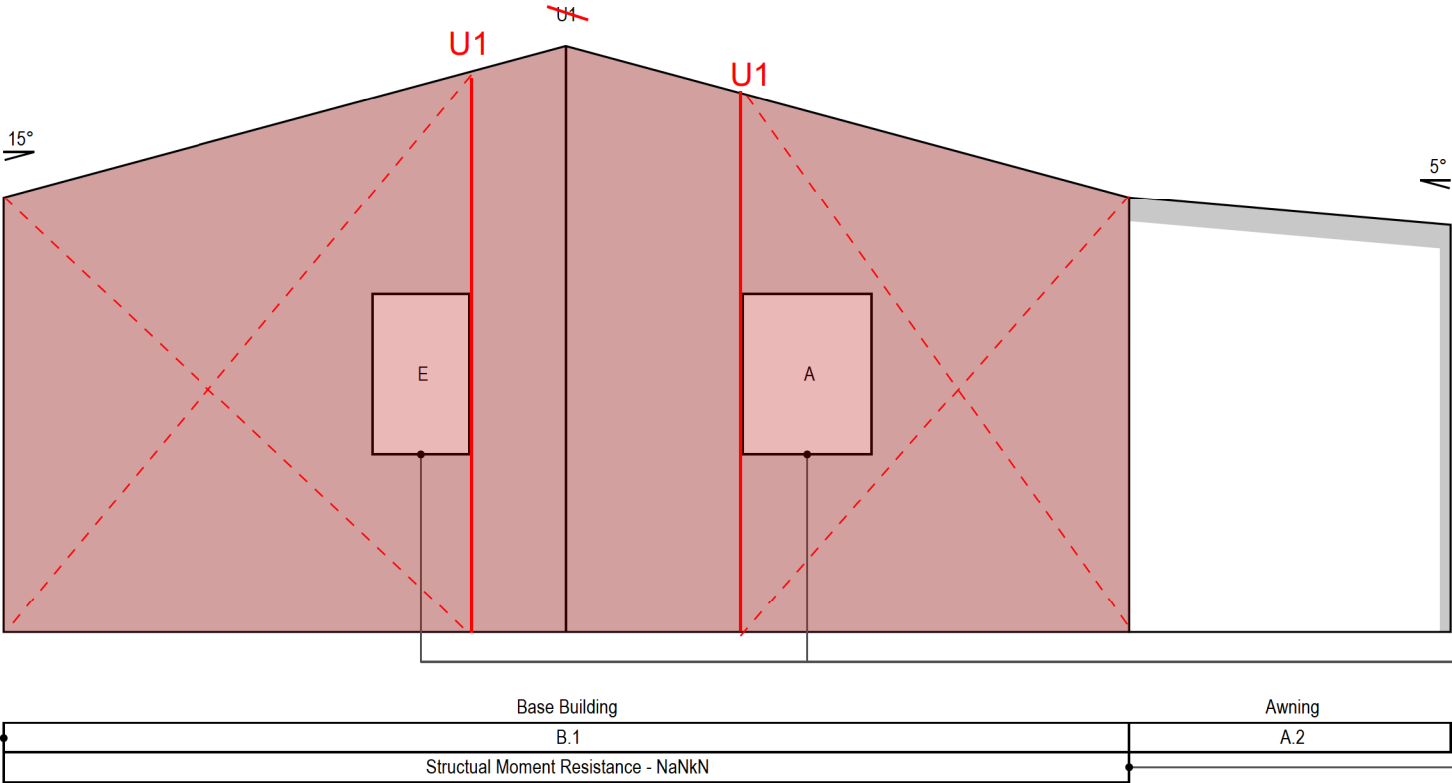

OPENING SECTION TABLES	
Opening - A	
Jambs & Head Beam	C80-75
Upper Support Girt	B80-75
Opening - E	
Jambs, Head Beam & Sill	C80-75
Upper & Lower Support Girt	B80-75
BRACING kN	
Required	NaN kN
Achieved	NaN kN




APPROVED
BC210007
22/02/2021
Andrew Nichols
Page 7 of 34
Central Hawkes Bay
District Council

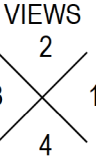



Project Ref: 1550193
© Copyright 2017 Spanbild NZ Ltd. All rights reserved.

Nathan Tritt
300 Homewood Road
Otane 4277
0272031205

Gable Range - Design
Engineering Tables
Sheet 8 of 20

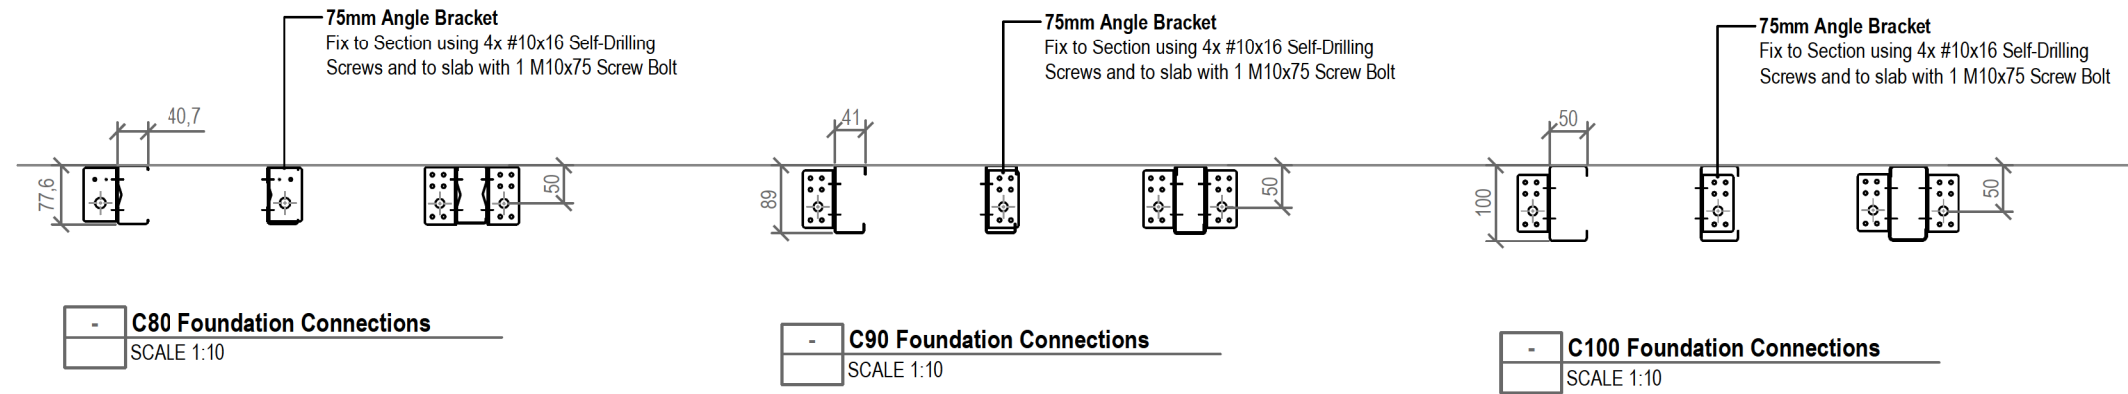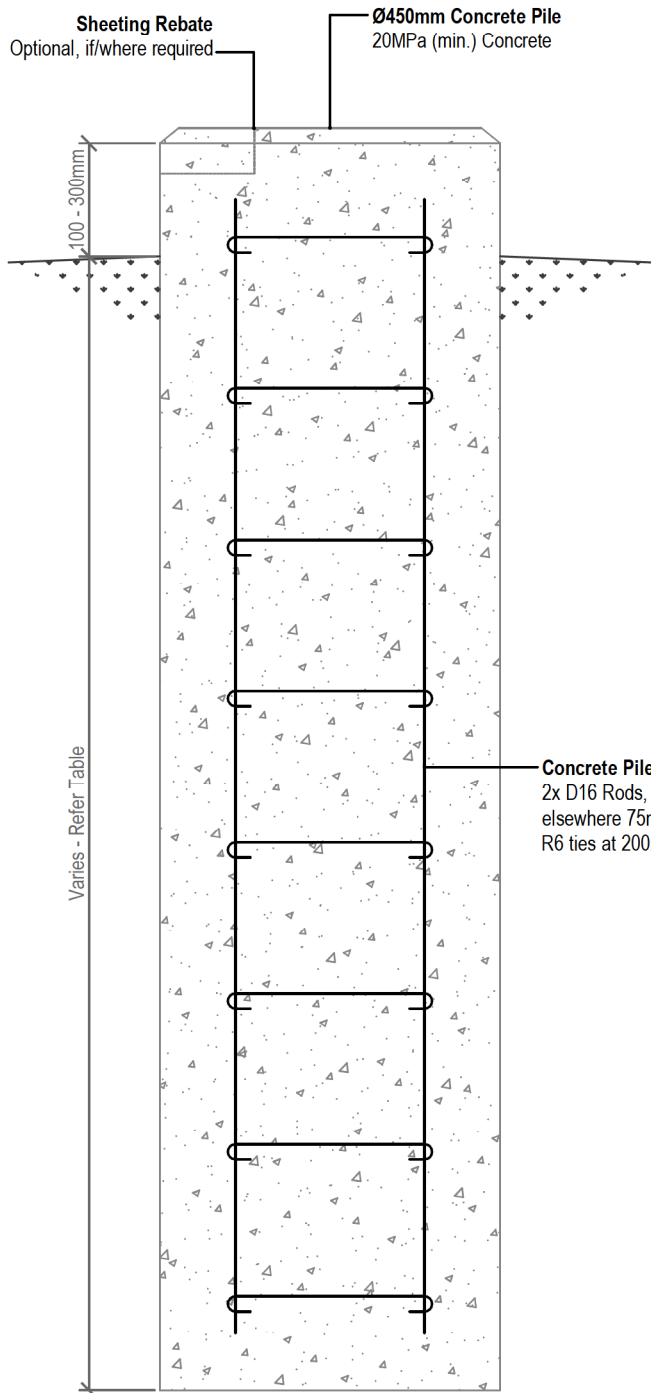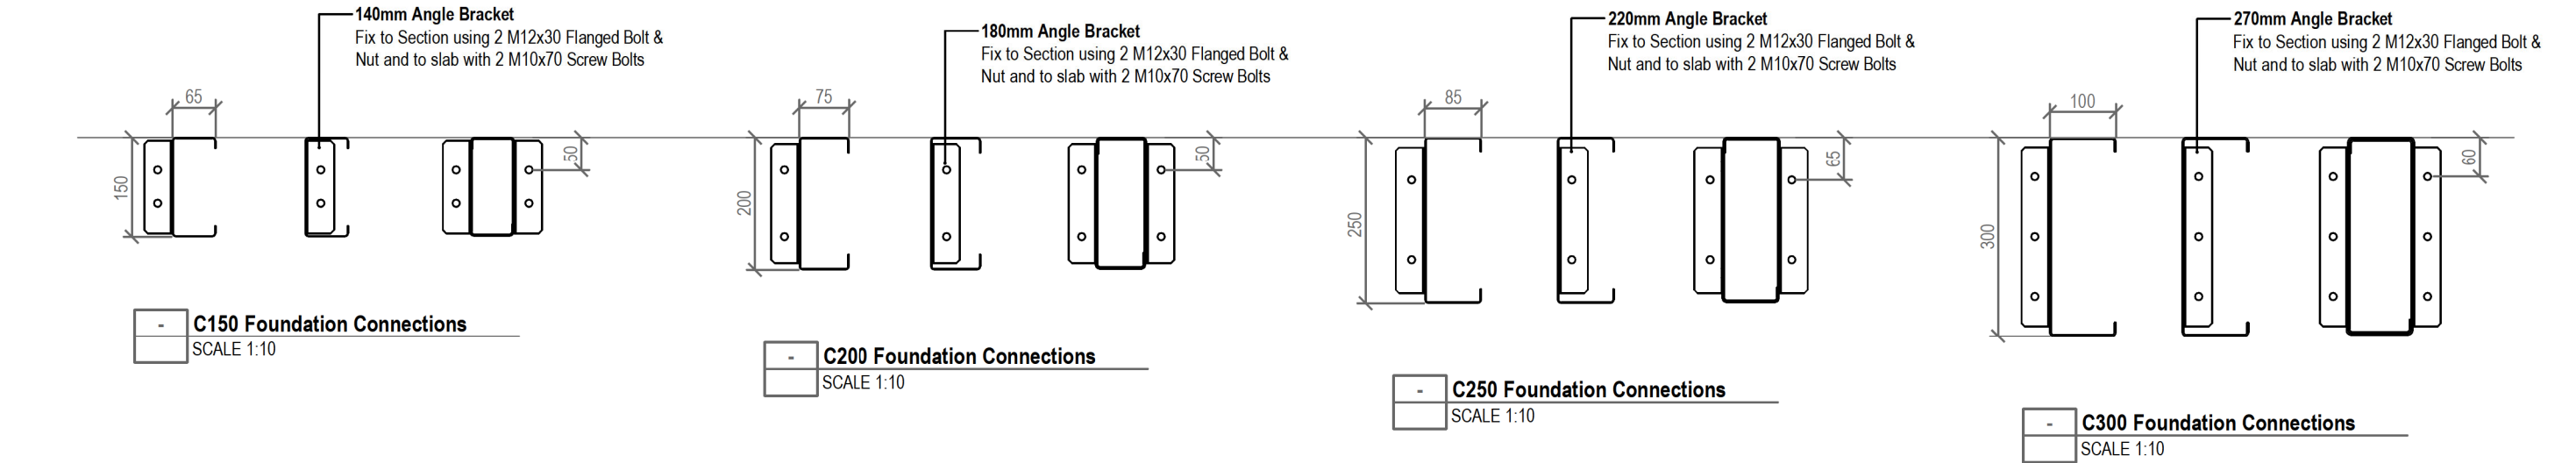

PILE FOUNDATION DEPTHS				
C Section	Boxed C Section	SHS	Pile Diameter	Depth Required, metres (m)
C80, C90, C100 & C150-75	2C80, 2C90 & 2C100	-	450	0.600
C150-10 to C150-19	2C150-75 & 2C150-10	65x65	450	1.000
C250-15	2C150-15	75x75 & 100x100	450	1.200
C250-19	2C150-19 & 2C250-15	-	450	1.500
C250-24, C300-24 & C300-30	2C250-19	-	450	2.000
-	2C250-24, 2C300-24 & 2C300-30	-	600	2.000

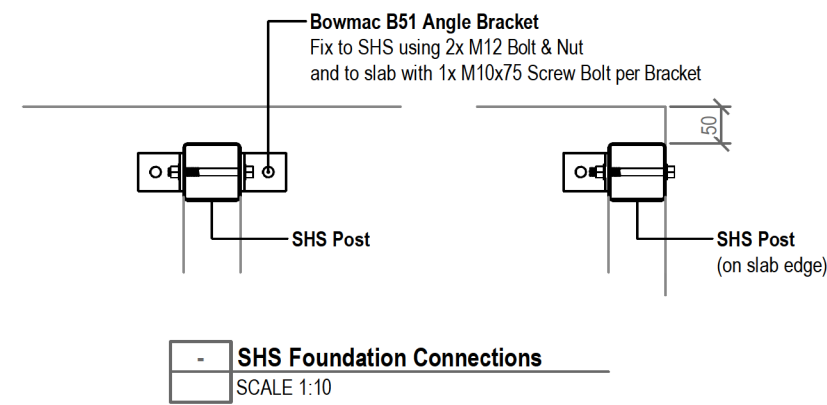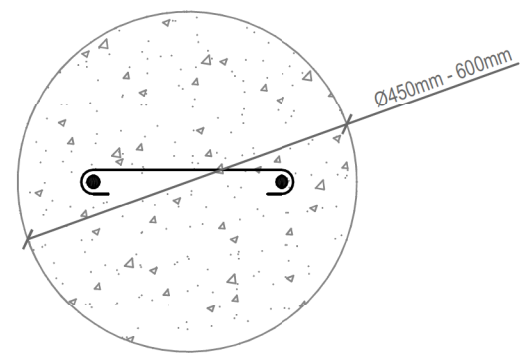

APPROVED
BC210007
22/02/2021
Andrew Nichols
Page 8 of 34
Central Hawkes Bay District Council


Project Ref: 1550193
© Copyright 2017 Spanbild NZ Ltd. All rights reserved.

Nathan Tritt
300 Homewood Road
Otane 4277
0272031205

Gable Range - Design

Foundation Details SD-F01

Sheet 9 of 20

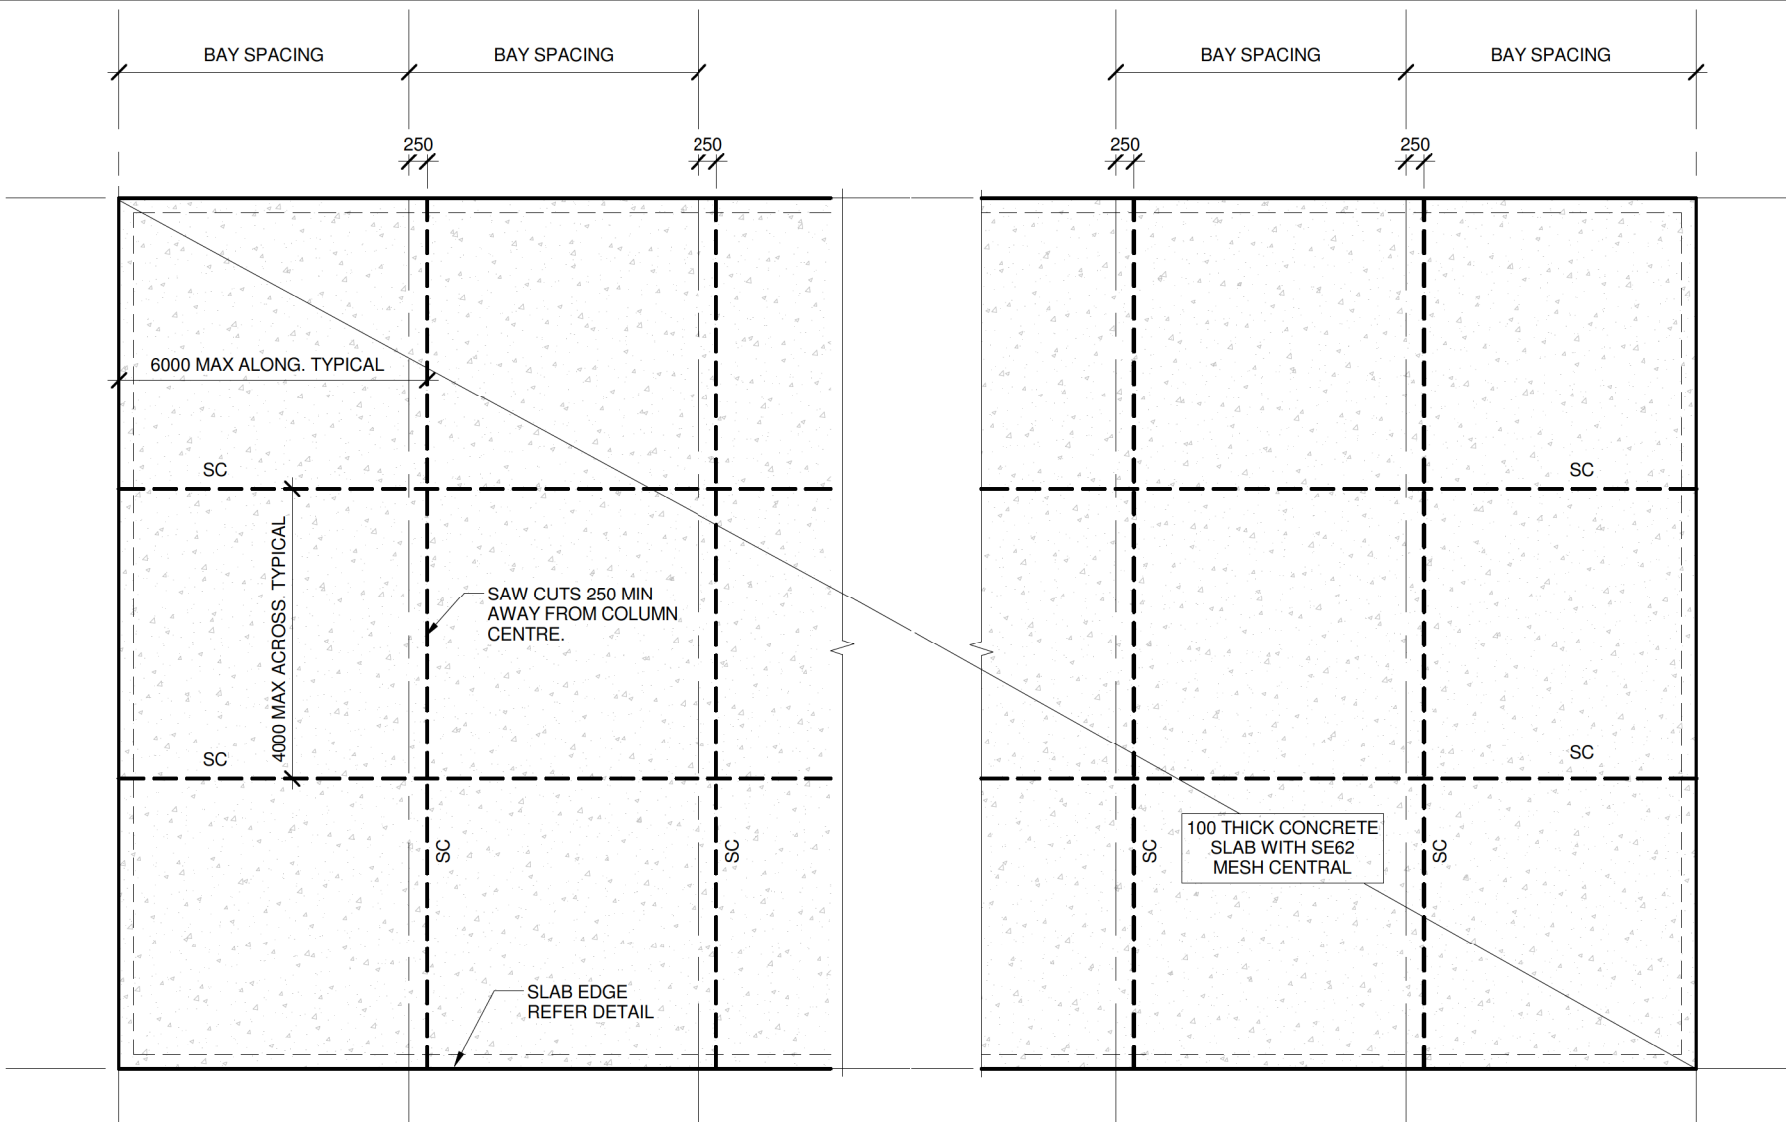

SLAB PLAN

SCALE: 1 : 100

NOTES

GENERAL:

- ALL WORK SHALL CONFORM TO THE NEW ZEALAND BUILDING CODE.
- CHECK DIAGONALS TO ENSURE BUILDING IS SQUARE.

FOUNDATIONS:

- FOUNDATION SUBGRADE TO BE GOOD GROUND AS DEFINED BY NZS3604:2011, EXCEPT HAVING A MINIMUM ULTIMATE BEARING CAPACITY OF 225kPa.

CONCRETE SLAB:

- STRIP THE SITE, REMOVING VEGETATION, TURF, SOILS CONTAINING ORGANIC MATTER AND LOOSE OR SOFT MATERIAL, TRIM TO A FIRM SUBGRADE. BACKFILL AS REQUIRED WITH COMPACTED GRANULAR MATERIAL AS DEFINED BY NZS3604:2011 AND LAY A BLINDING OF SAND TO UNDERSIDE OF CONCRETE SLAB AND EDGE THICKENINGS. ENSURE THE SURFACE OF THE SLAB WILL BE AT LEAST 100mm ABOVE THE HIGHEST LEVEL OF CLEARED GROUND AROUND SLAB.
- CONCRETE SHALL HAVE A MAXIMUM AGGREGATE SIZE OF 20mm AND A SLUMP OF 80mm.
- REINFORCING MESH TO BE LAPPED 225mm.
- PROVIDE A 0.25mm POLYTHENE DAMP PROOF MEMBRANE AND SLIP LAYER UNDER THE SLAB TAPED WITH 100mm LAPS.
- CONCRETE REINFORCING STEEL TO BE SUPPORTED BY PLASTIC CHAIRS AT 800mm CRS.
- CONCRETE TO BE 20MPa UP TO ZONE C AND 25MPa FOR ZONE D
- COVER TO REINFORCING SHALL BE...
 - 75mm FROM GROUND
 - 50mm FROM GROUND PROTECTED BY DPM
 - 25mm FROM INTERNAL SURFACES
 - 50mm FROM EXTERNAL SURFACES

REINFORCEMENT NOTATION:

- R - G300E PLAIN BAR REINFORCEMENT.
D - G300E DEFORMED BAR REINFORCEMENT.
HD - G500E DEFORMED BAR REINFORCEMENT.

REINFORCEMENT NOTATION: R10-600


REINFORCEMENT TYPE
NOMINATION
10mm DIAMETER

600mm SPACING

ABBREVIATIONS:


EQ - EQUAL SPACING
FGL - FINISHED GROUND LEVEL

ALL DIMENSIONS ARE IN MILLIMETRES UNLESS NOTED OTHERWISE.

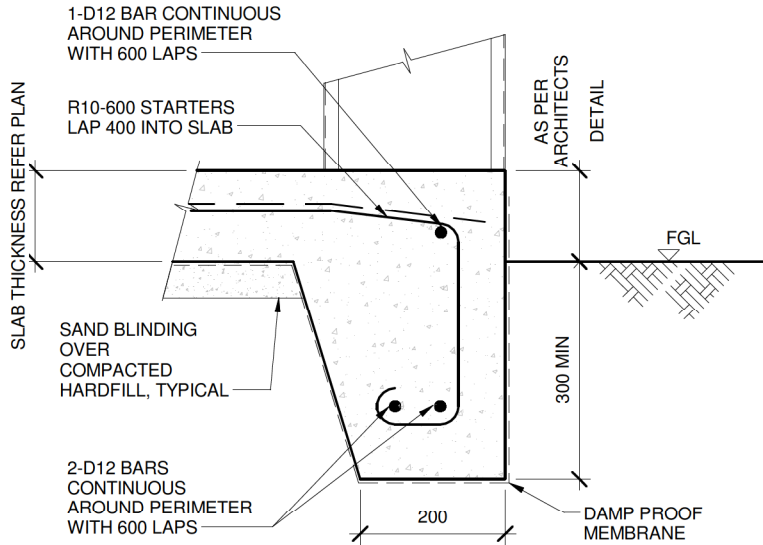


SLAB EDGE DETAIL

SCALE: 1 : 10

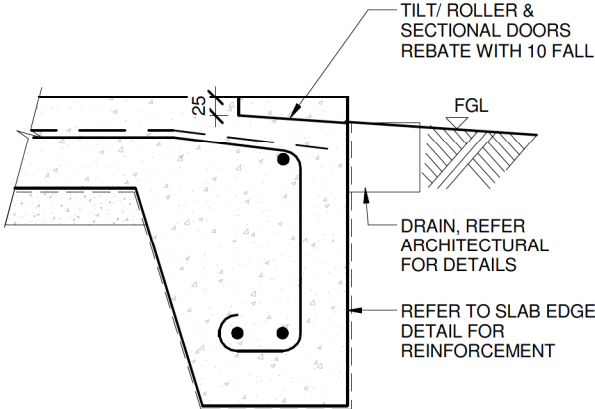


P.A. DOOR & GARAGE DOOR
ENTRY SLAB EDGE DETAIL

SCALE: 1 : 10

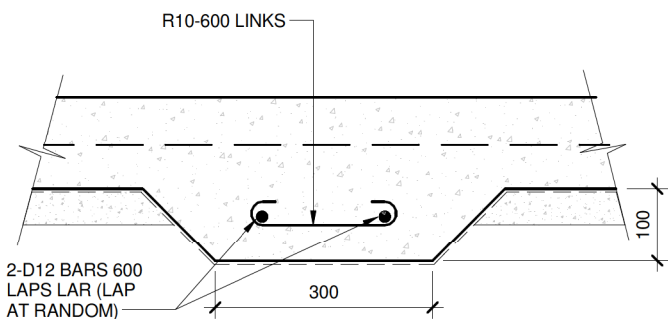


TYPICAL SLAB THICKENING
DETAIL BELOW INTERNAL WALLS

SCALE: 1 : 10

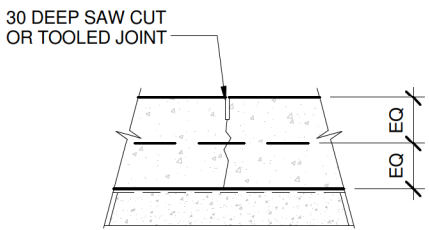


SAW CUT (SC) DETAIL

SCALE: 1 : 10

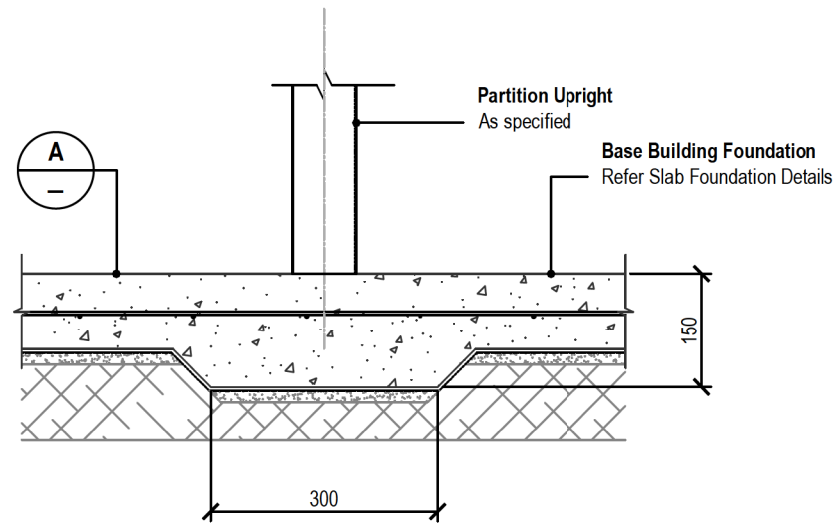


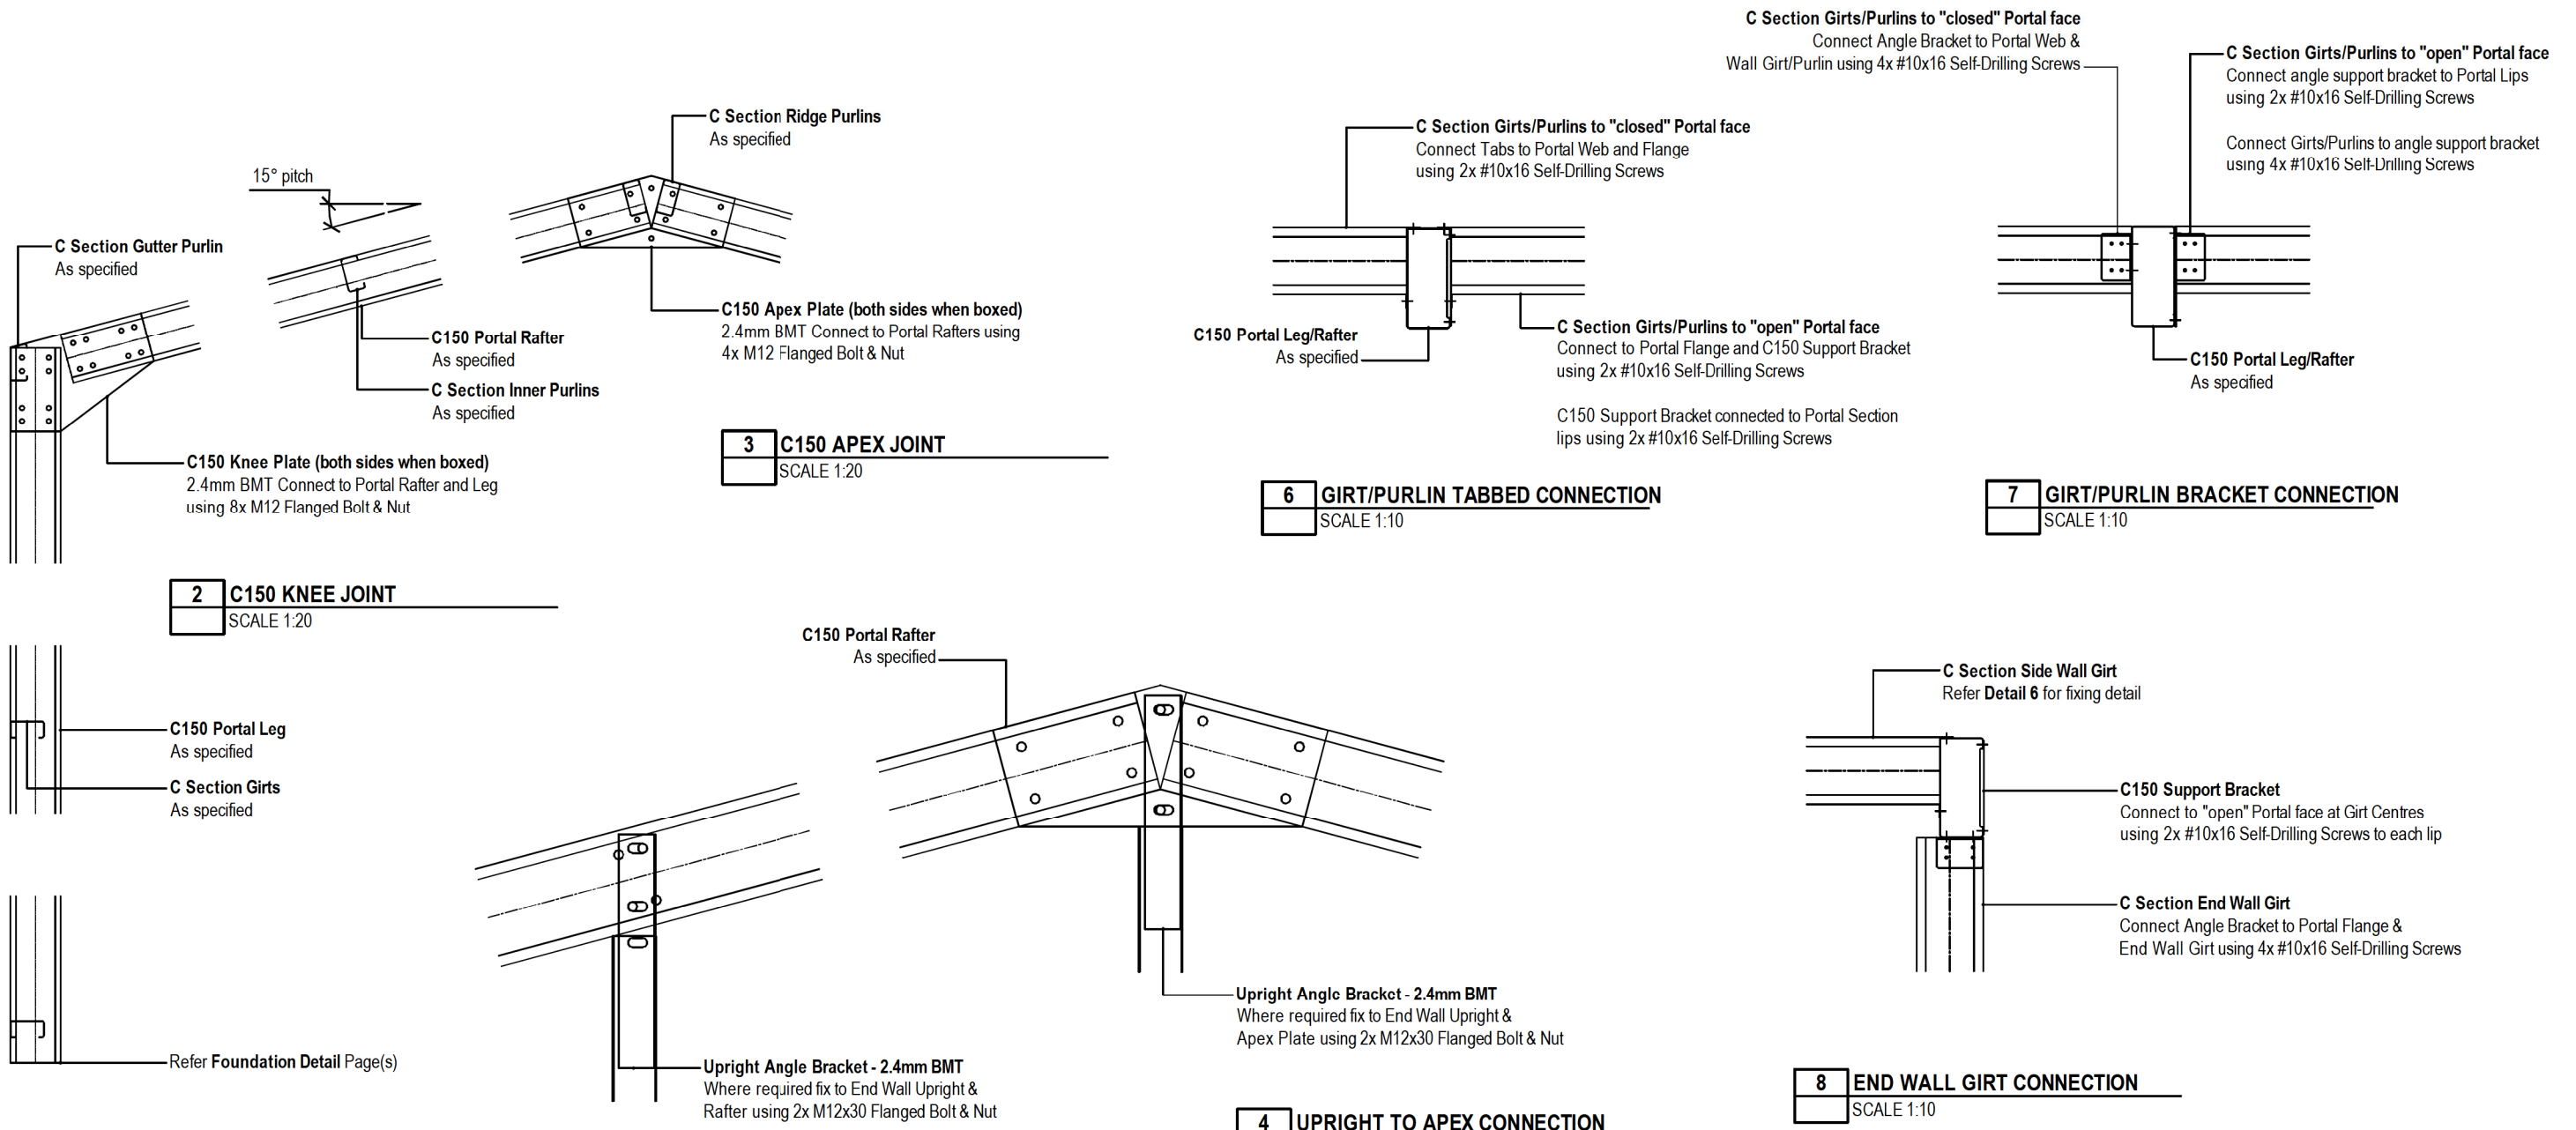
1	300x300x150 PAD
	SCALE 1:10

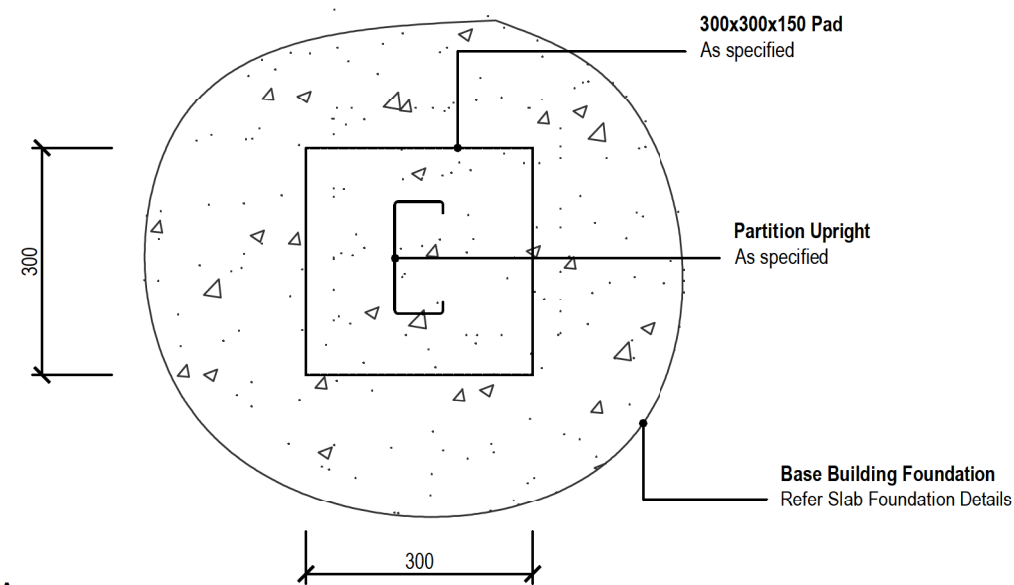


A	Section A
	SCALE 1:10

APPROVED
BC210007
22/02/2021
Andrew Nichols
Page 10 of 34
Central Hawkes Bay
District Council



Project Ref: 1550193 © Copyright 2017 Spanbild NZ Ltd. All rights reserved.
Nathan Tritt 300 Homewood Road Otane 4277 0272031205
Gable Range - Design
Foundation Details SD-F05.1
Sheet 11 of 20



APPROVED
BC210007
22/02/2021
Andrew Nichols
Page 11 of 34
Central Hawkes Bay
District Council

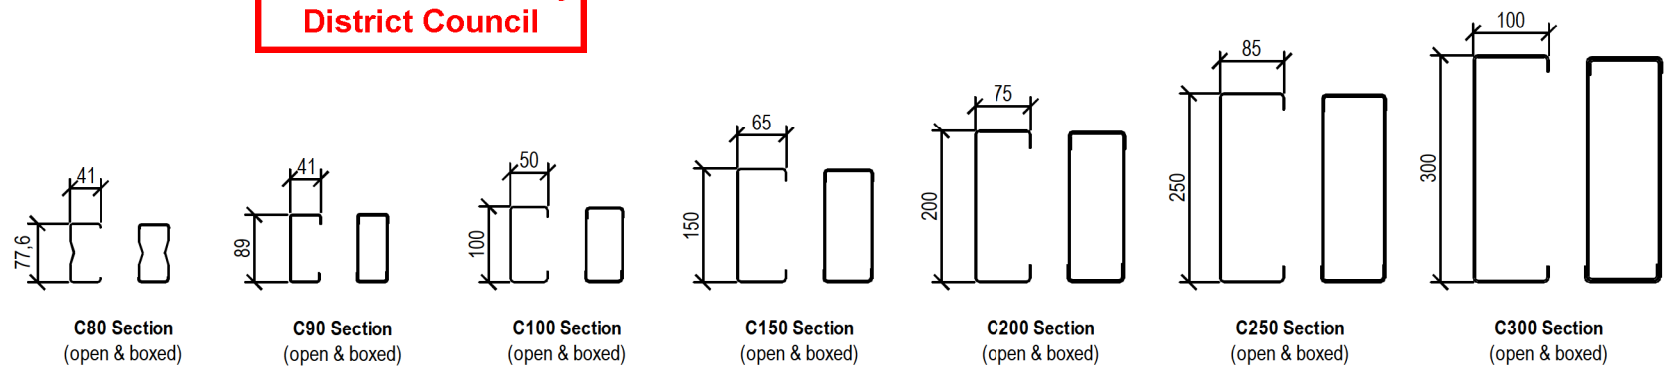

C SECTION PROFILES (INCL. BOXING)
SCALE 1:20

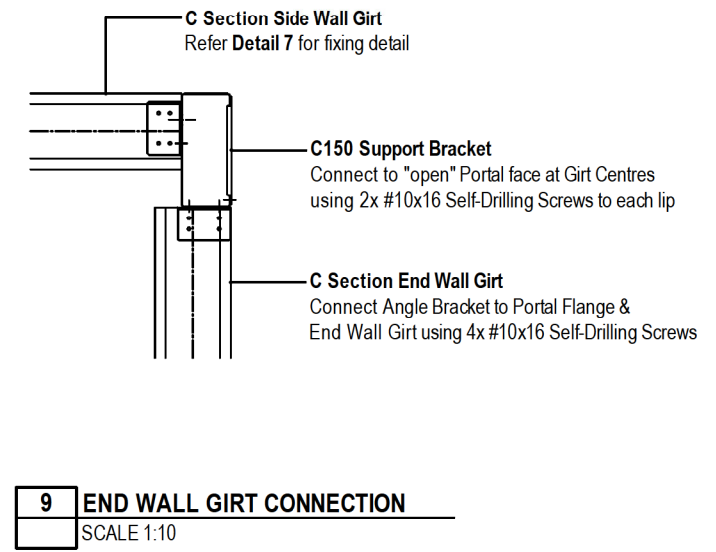



Project Ref: 1550193
© Copyright 2017 Spanbild NZ Ltd. All rights reserved.

Nathan Tritt
300 Homewood Road
Otane 4277
0272031205

Gable Range - Design

Frame Details SD-P01

Sheet 12 of 20

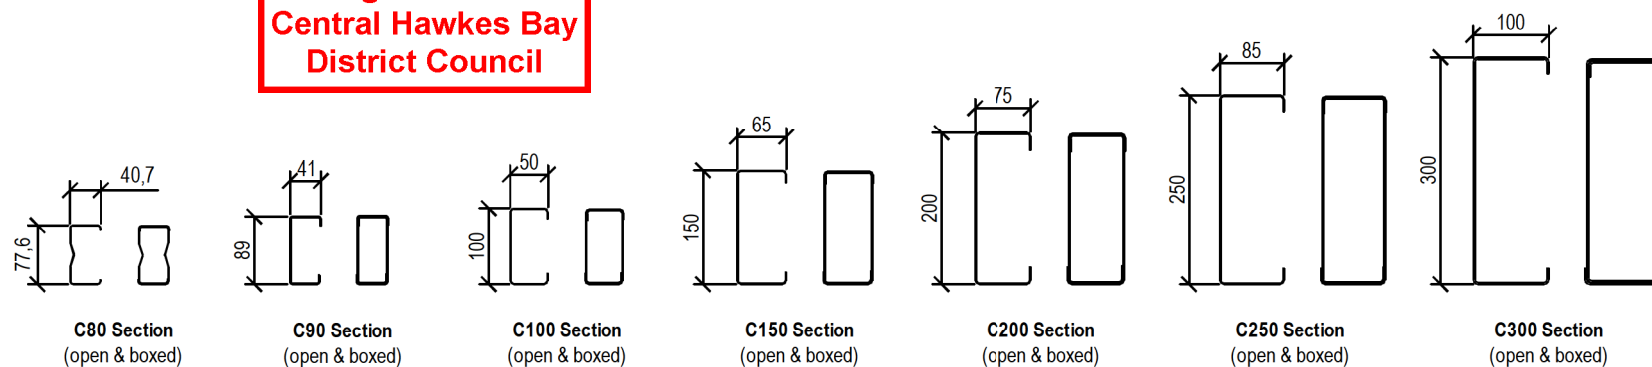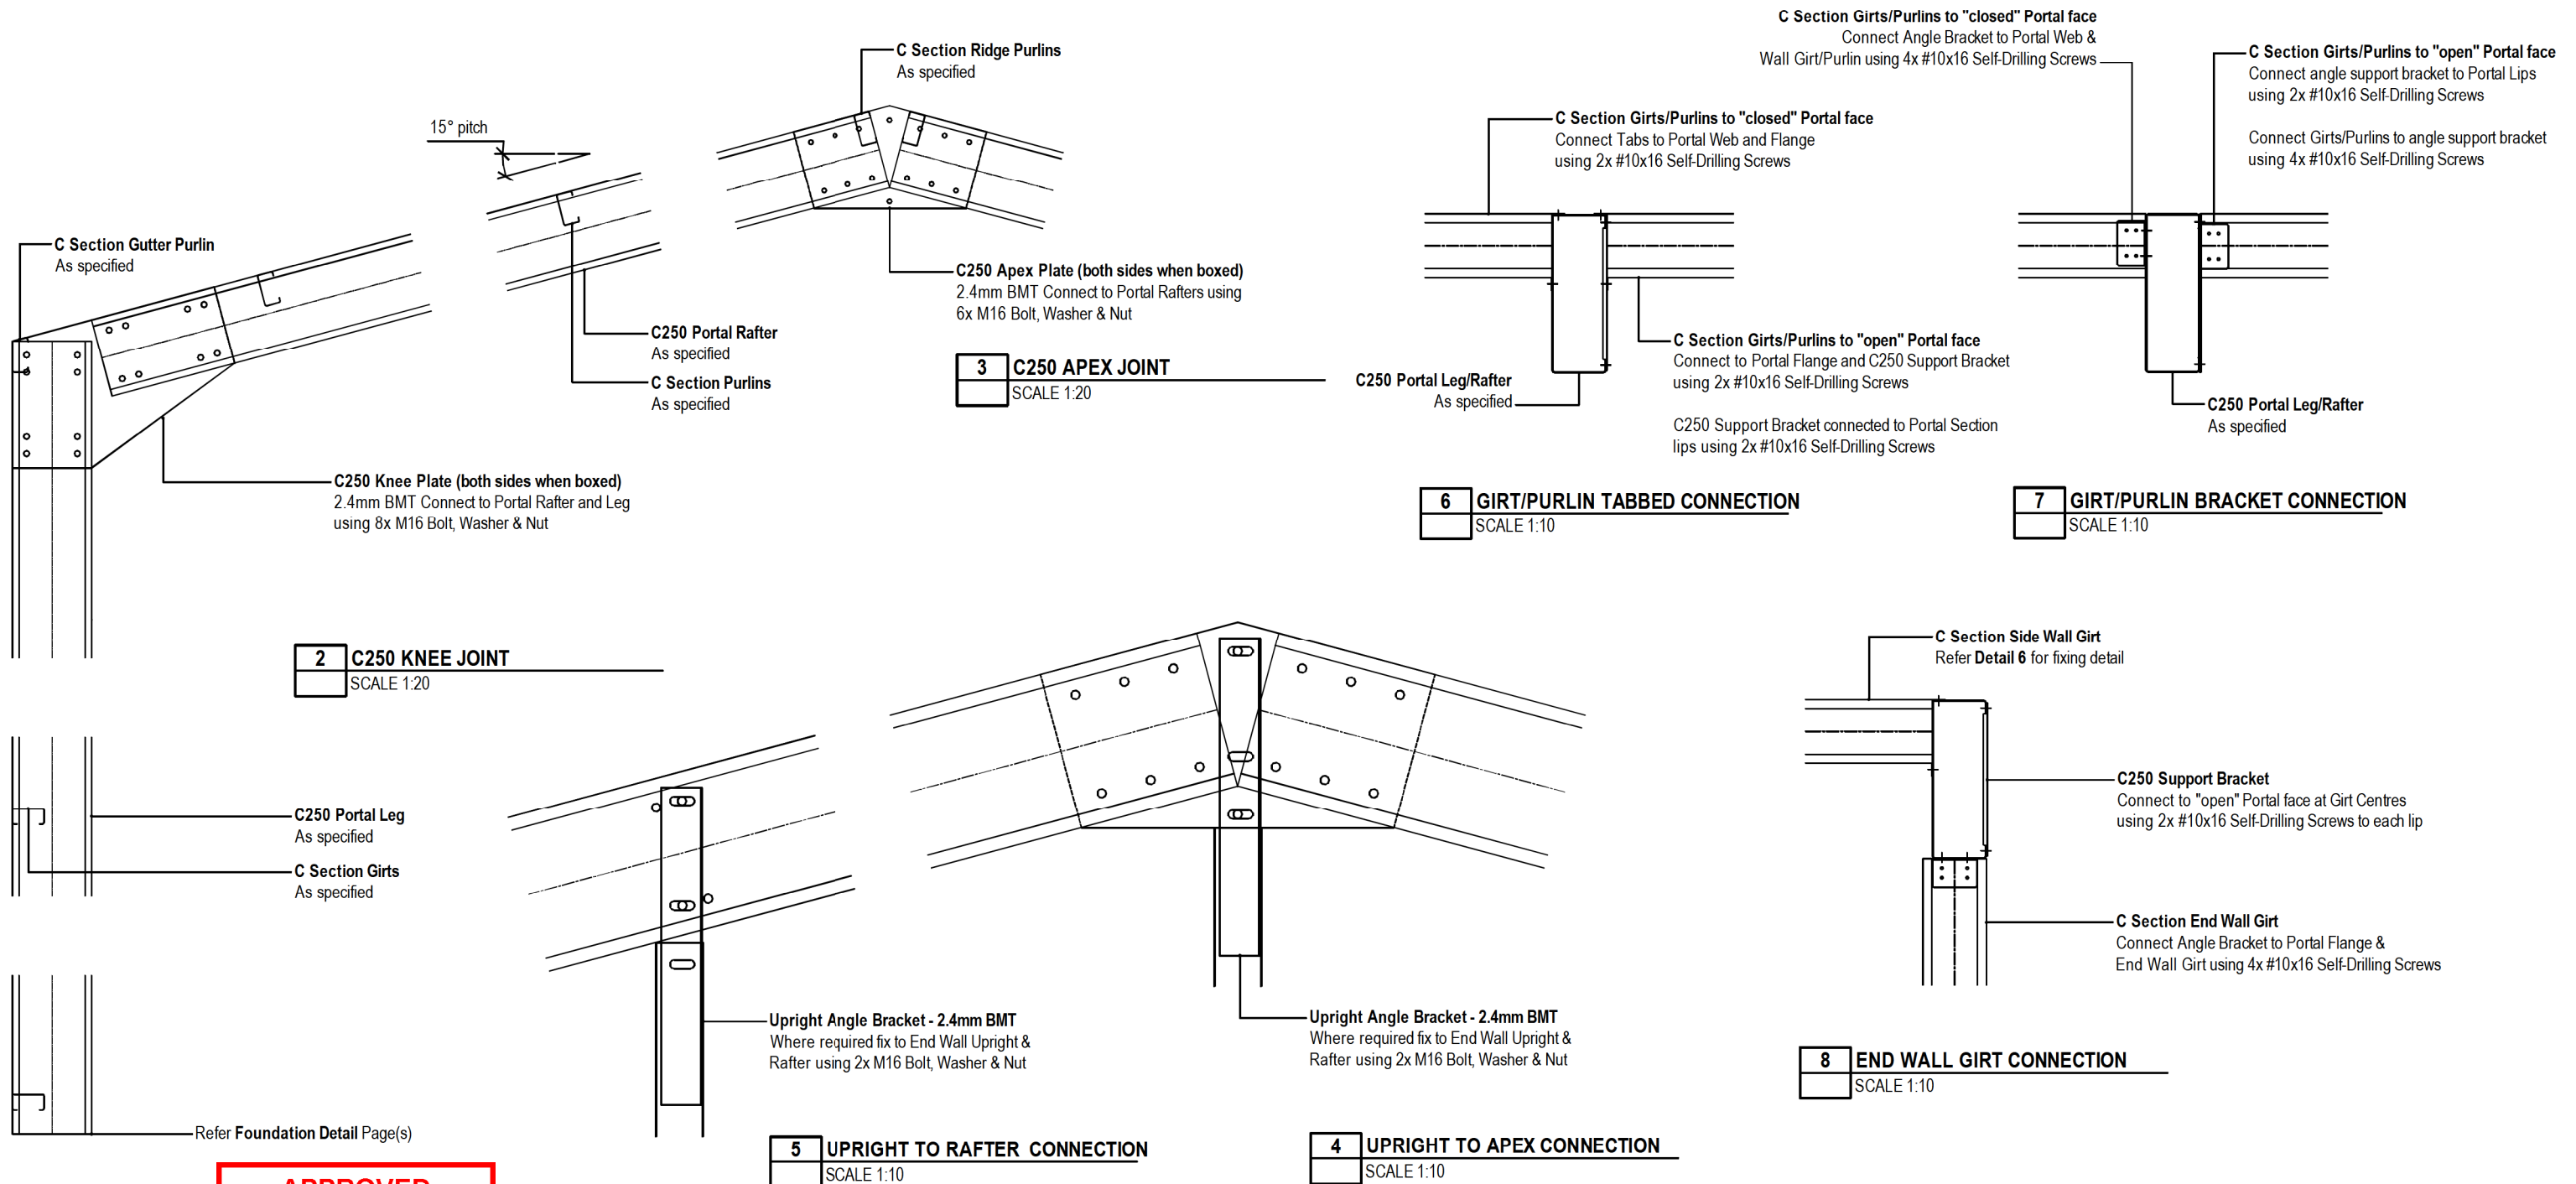

C SECTION PROFILES (INCL. BOXING)
SCALE 1:20

APPROVED
BC210007
22/02/2021
Andrew Nichols
Page 12 of 34
Central Hawkes Bay
District Council





Project Ref: 1550193
© Copyright 2017 Spanbild NZ Ltd. All rights reserved.

Nathan Tritt
300 Homewood Road
Otane 4277
0272031205

Gable Range - Design

Frame Details SD-P03

Sheet 13 of 20

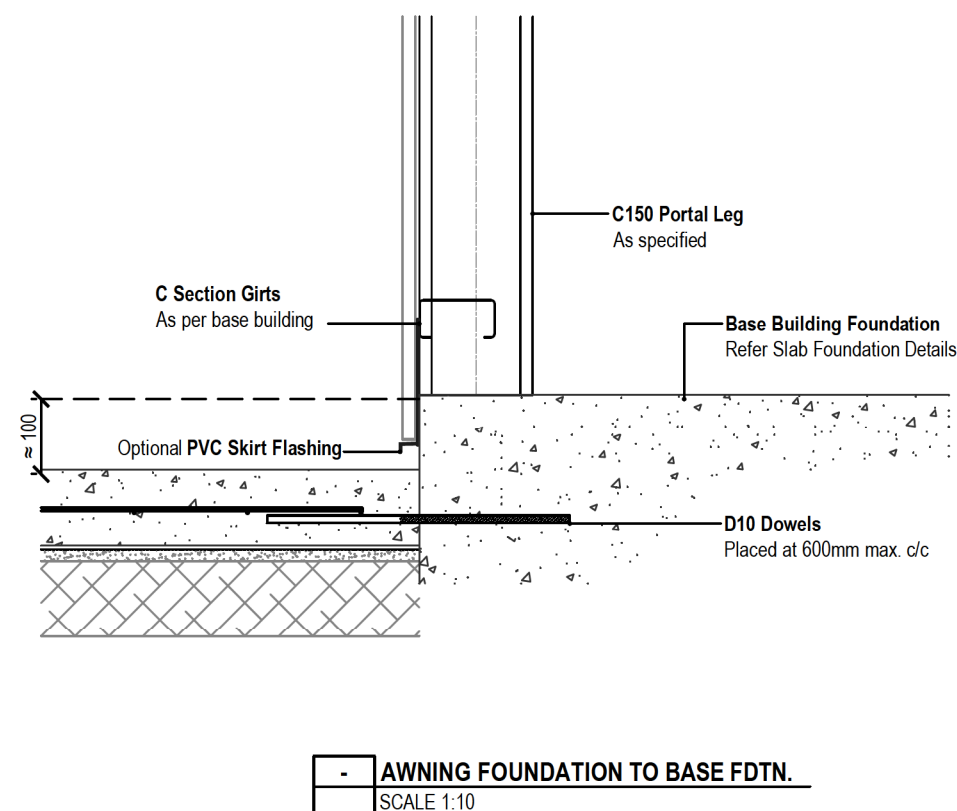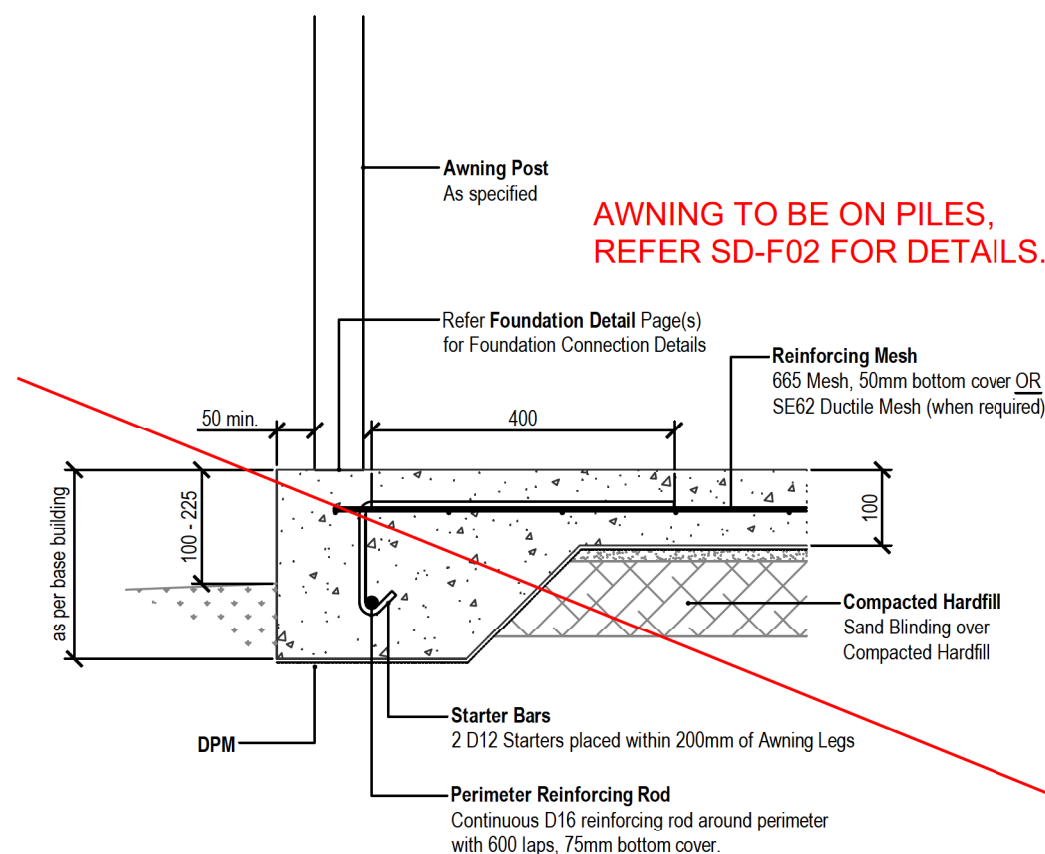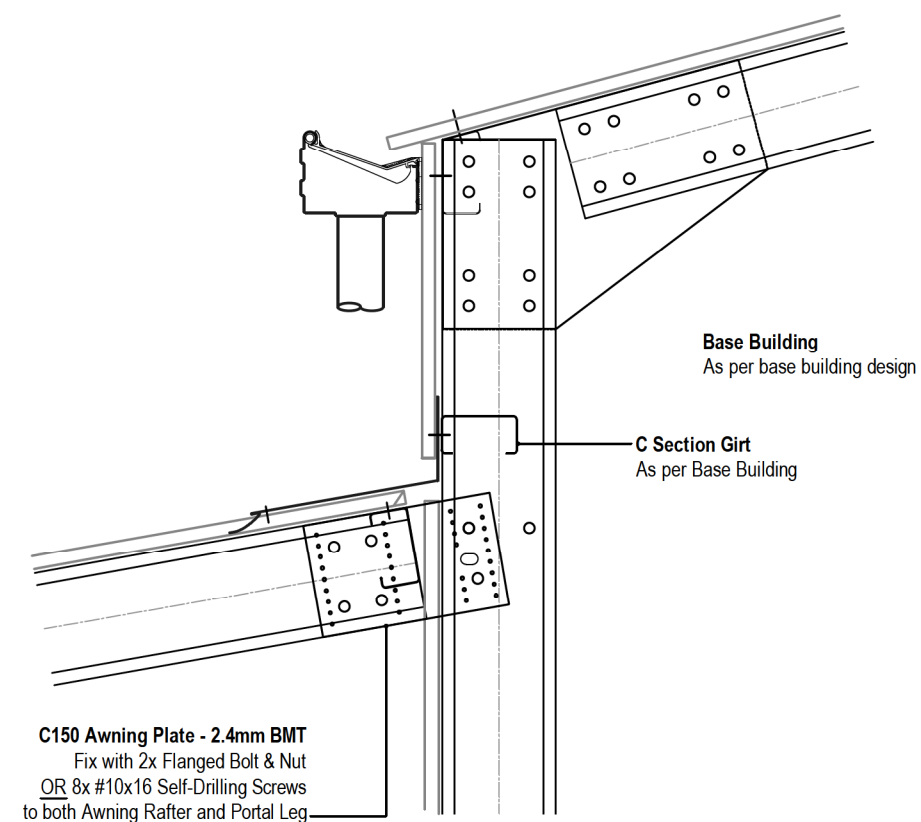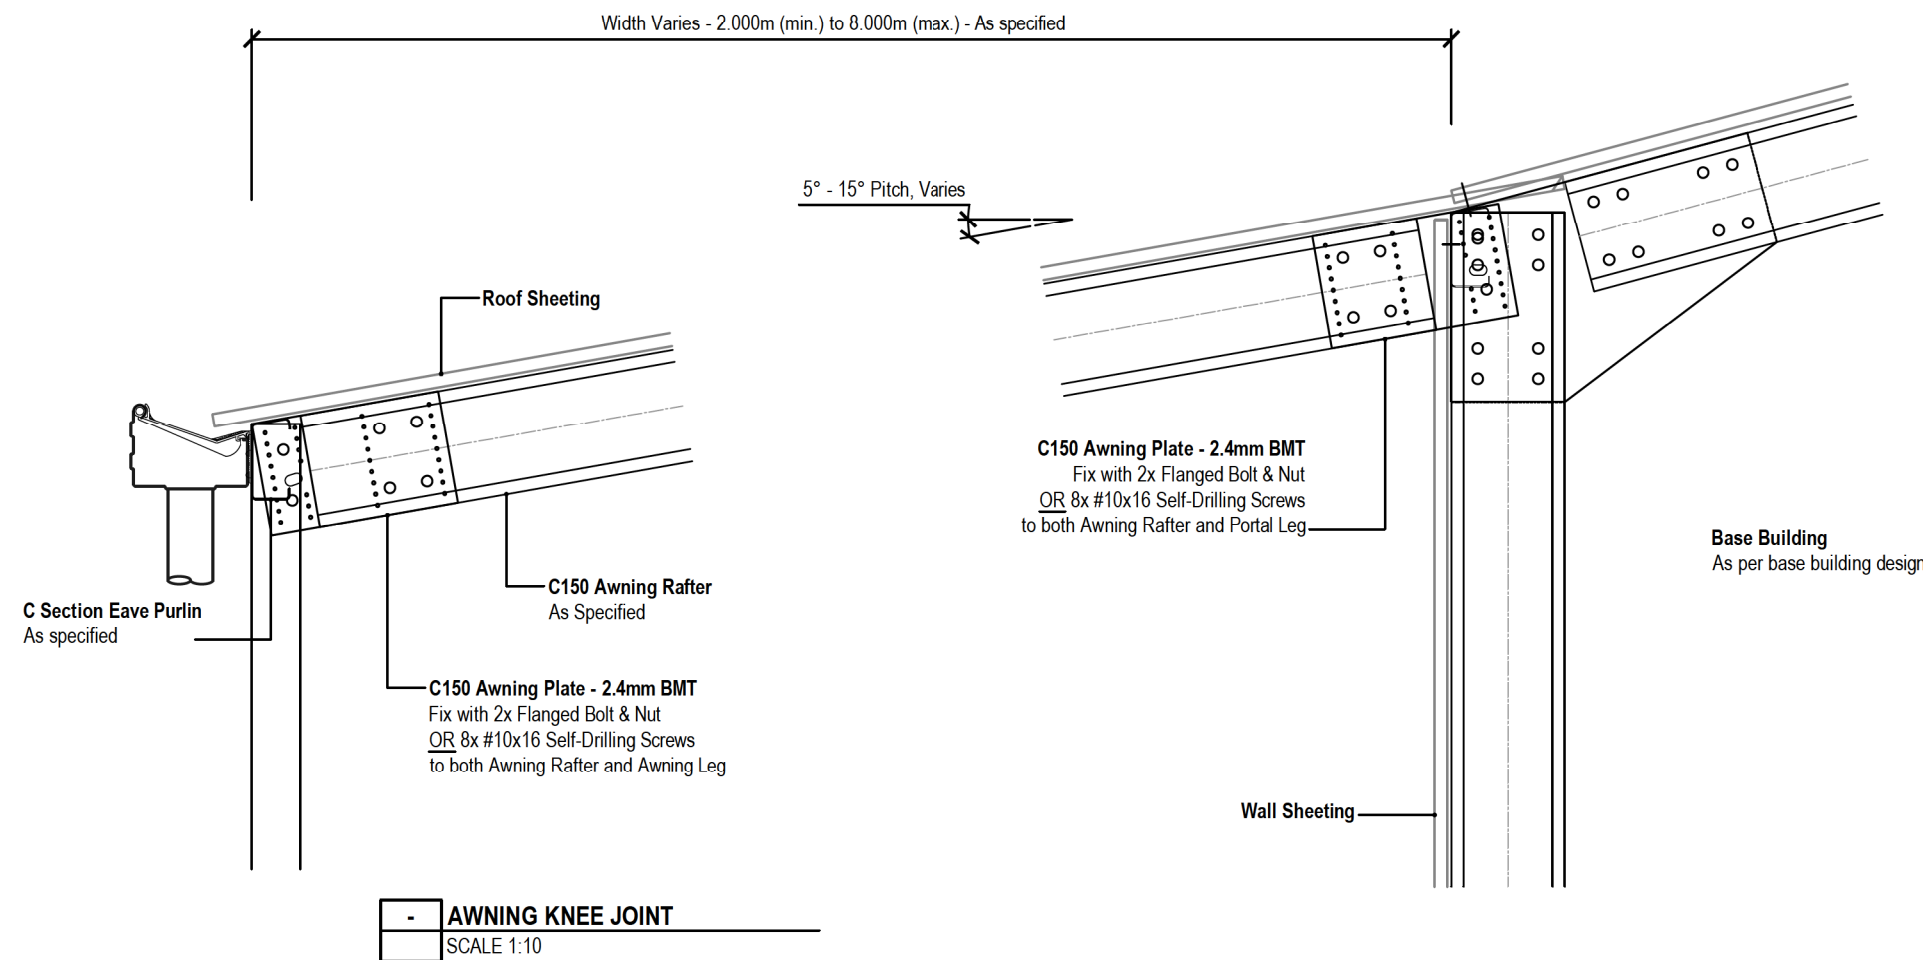

NOTES

- 1 Awning Foundation to have a 1:100 fall
- 2 Wall Girts (providing restraint to Portal Legs) shall only be removed/altered in accordance with standard opening specifications, drawings: SD-M01 to SD-M06 & SD-O01. Alternative configurations shall require a specific design certificate for the scope of work.

APPROVED
BC210007
22/02/2021
Andrew Nichols
Page 13 of 34
Central Hawkes Bay
District Council

TOTALSPAN®
STEEL BUILDINGS


Project Ref: 1550193
© Copyright 2017 Spanbild NZ Ltd. All rights reserved.

Nathan Tritt
300 Homewood Road
Otane 4277
0272031205

Gable Range - Design

Frame Details SD-A01


Sheet 14 of 20

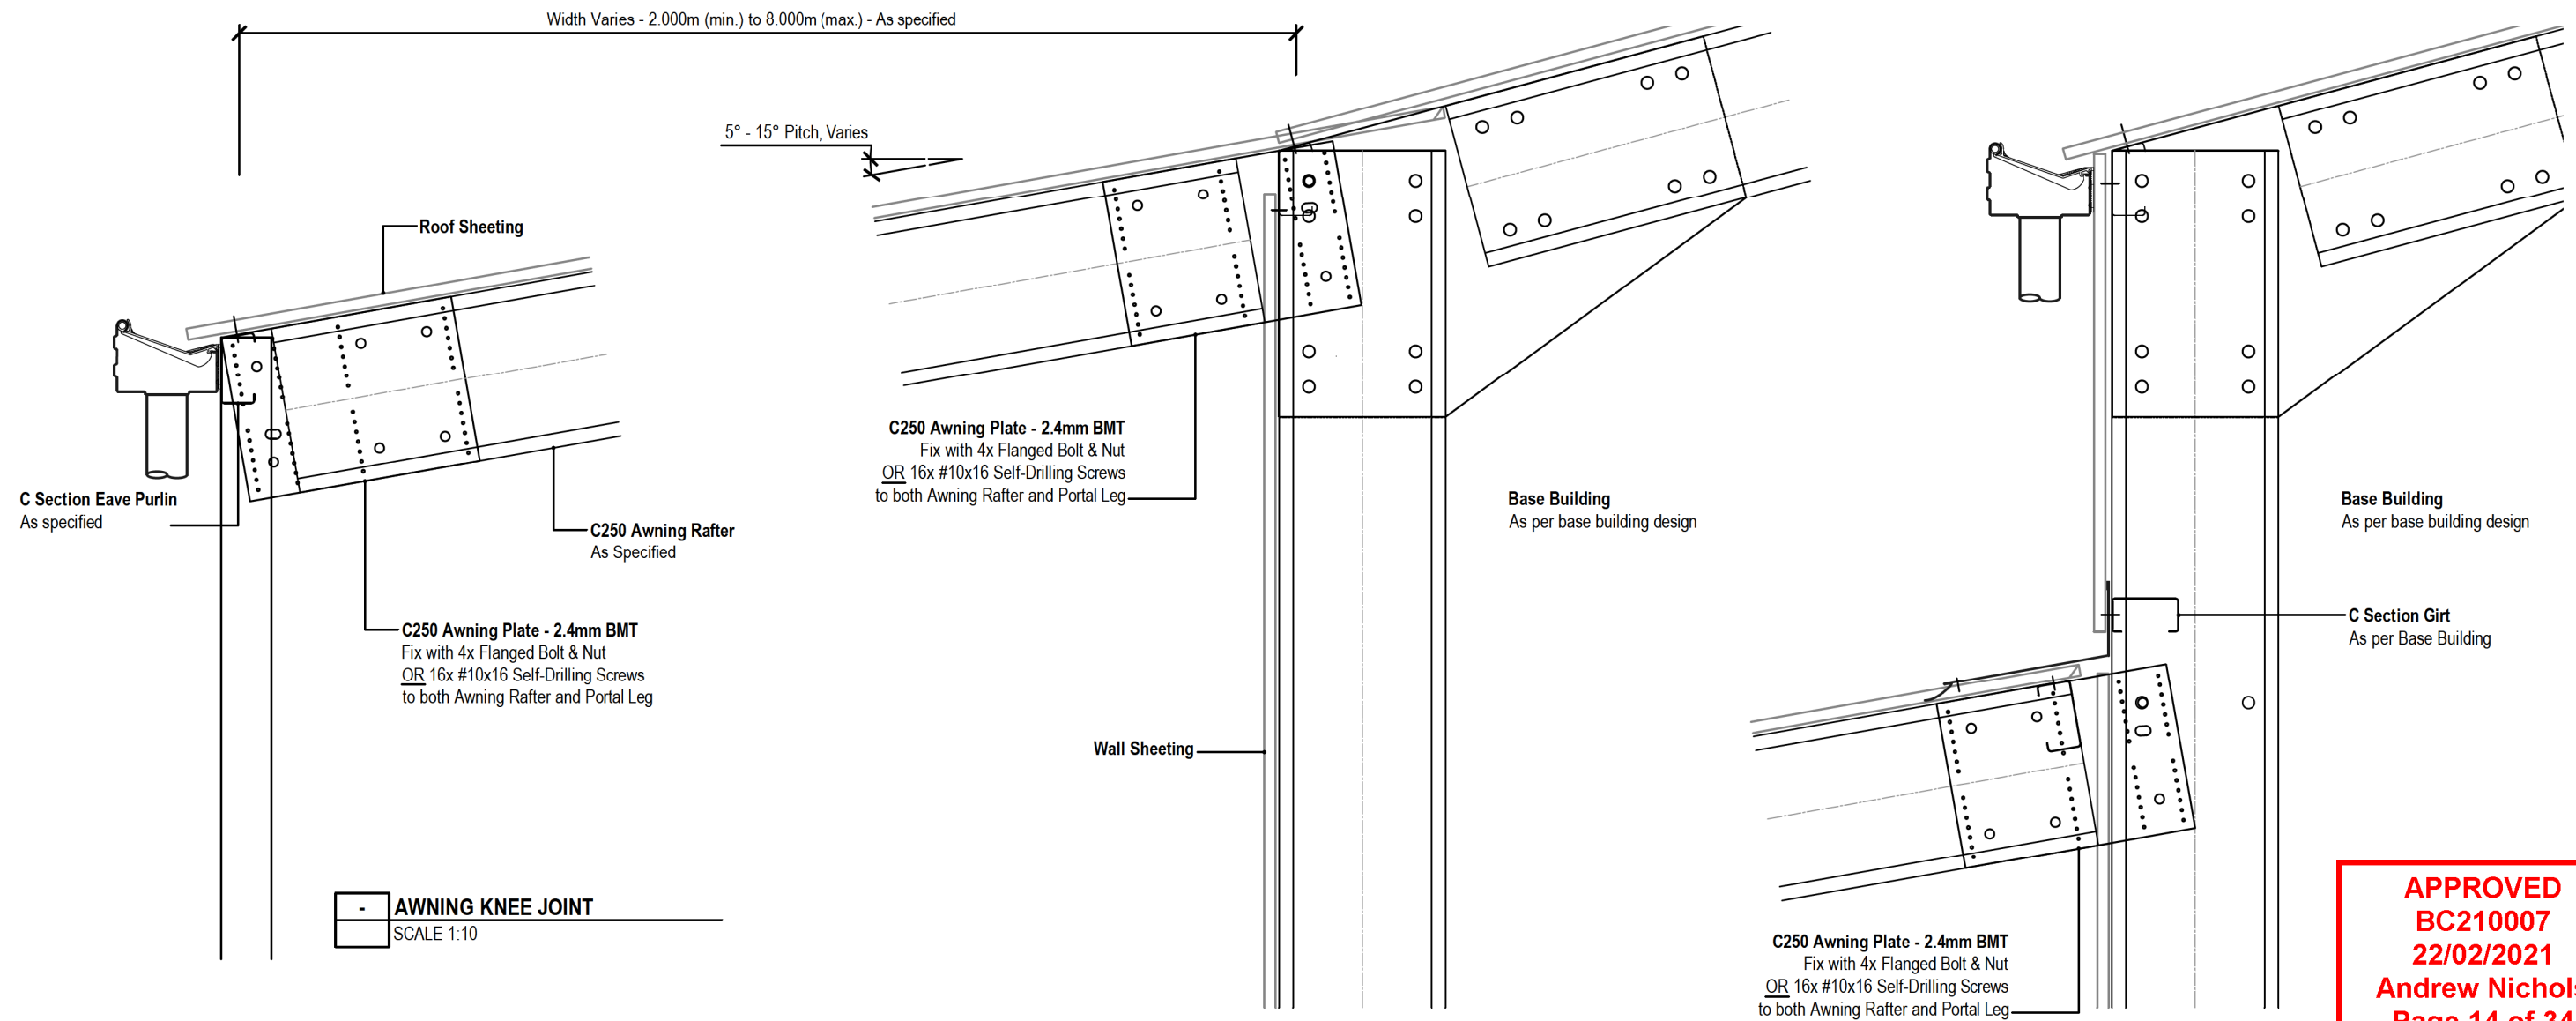


- **AWNING KNEE JOINT**
SCALE 1:10

- **AWNING CONNECTION TO BASE BUILDING**
SCALE 1:10

APPROVED
BC210007
22/02/2021
Andrew Nichols
Page 14 of 34
Central Hawkes Bay
District Council

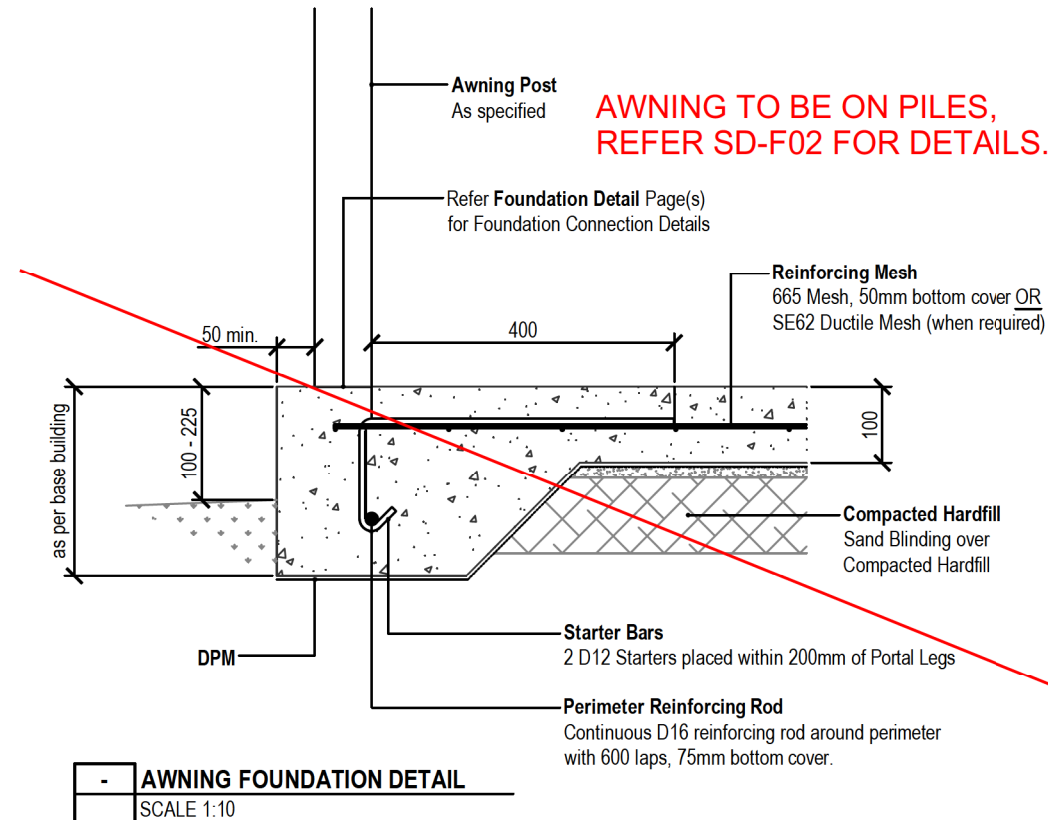

- **AWNING FOUNDATION DETAIL**
SCALE 1:10

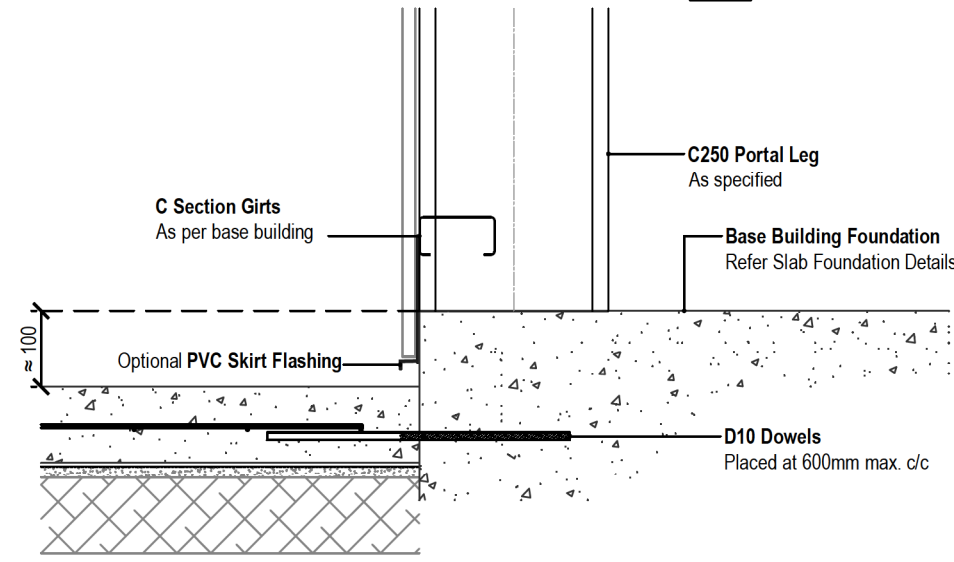

- **AWNING FOUNDATION TO BASE FDTN.**
SCALE 1:10

NOTES
1 Awning Foundation to have a 1:100 fall
2 Wall Girts (providing restraint to Portal Legs) shall only be removed/altered in accordance with standard opening specifications, drawings: SD-M01 to SD-M06 & SD-001. Alternative configurations shall require a specific design certificate for the scope of work.



Project Ref: 1550193
© Copyright 2017 Spanbild NZ Ltd. All rights reserved.

Nathan Tritt
300 Homewood Road
Otane 4277
0272031205


Gable Range - Design

Frame Details SD-A02


Sheet 15 of 20

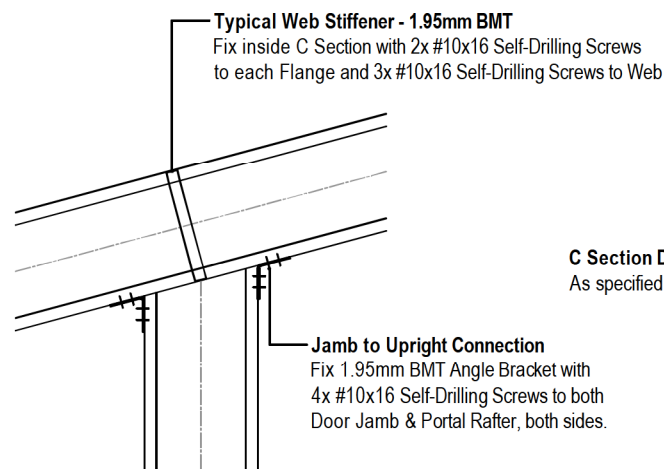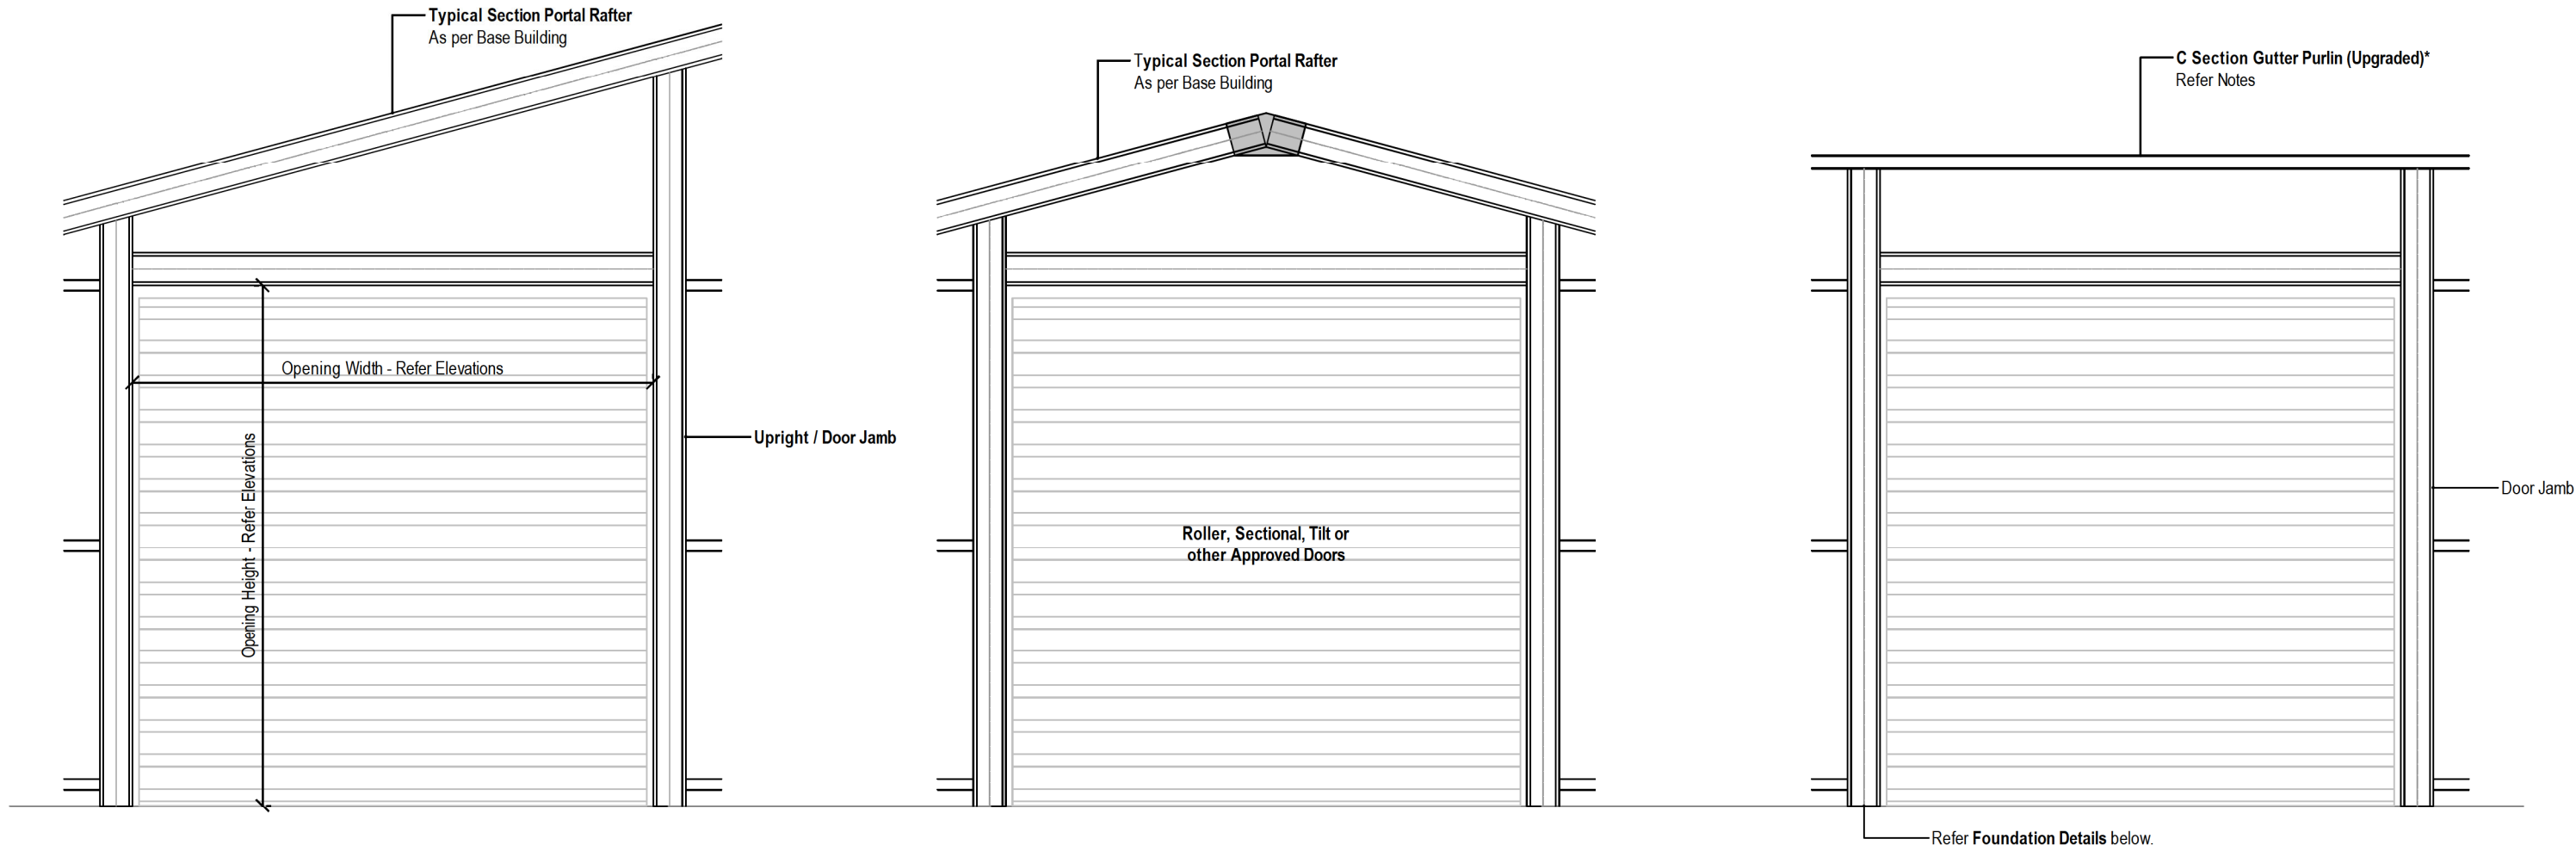


- **DOOR JAMB/UPRIGHT TO RAFTER CONNECTION**
SCALE 1:10

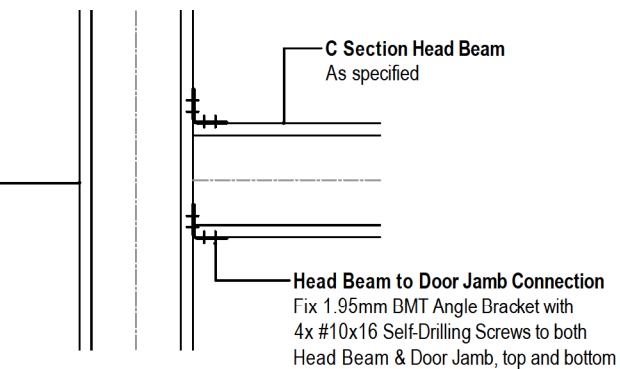


- **HEAD BEAM TO DOOR JAMB CONNECTION**
SCALE 1:10

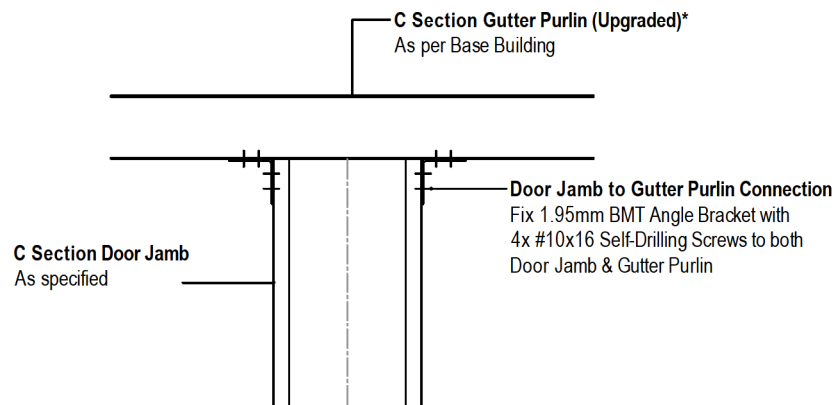

- **HEAD BEAM TO GUTTER PURLIN CONNECTION**
SCALE 1:10

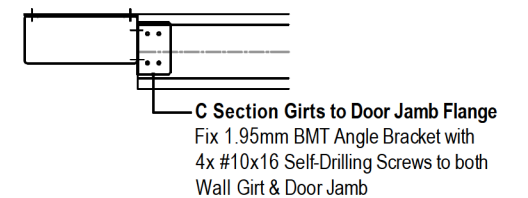


- **GIRT TO DOOR JAMB CONNECTION**
SCALE 1:10

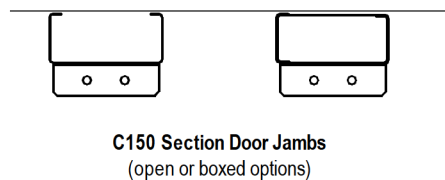

- **C150 Jamb to Foundation Connections**
SCALE 1:10

APPROVED
BC210007
22/02/2021
Andrew Nichols
Page 15 of 34
Central Hawkes Bay
District Council



Project Ref: 1550193


© Copyright 2017 Spanbild NZ Ltd. All rights reserved.

Nathan Tritt
300 Homewood Road
Otane 4277
0272031205



Gable Range - Design

Major Openings SD-M01

Sheet 16 of 20

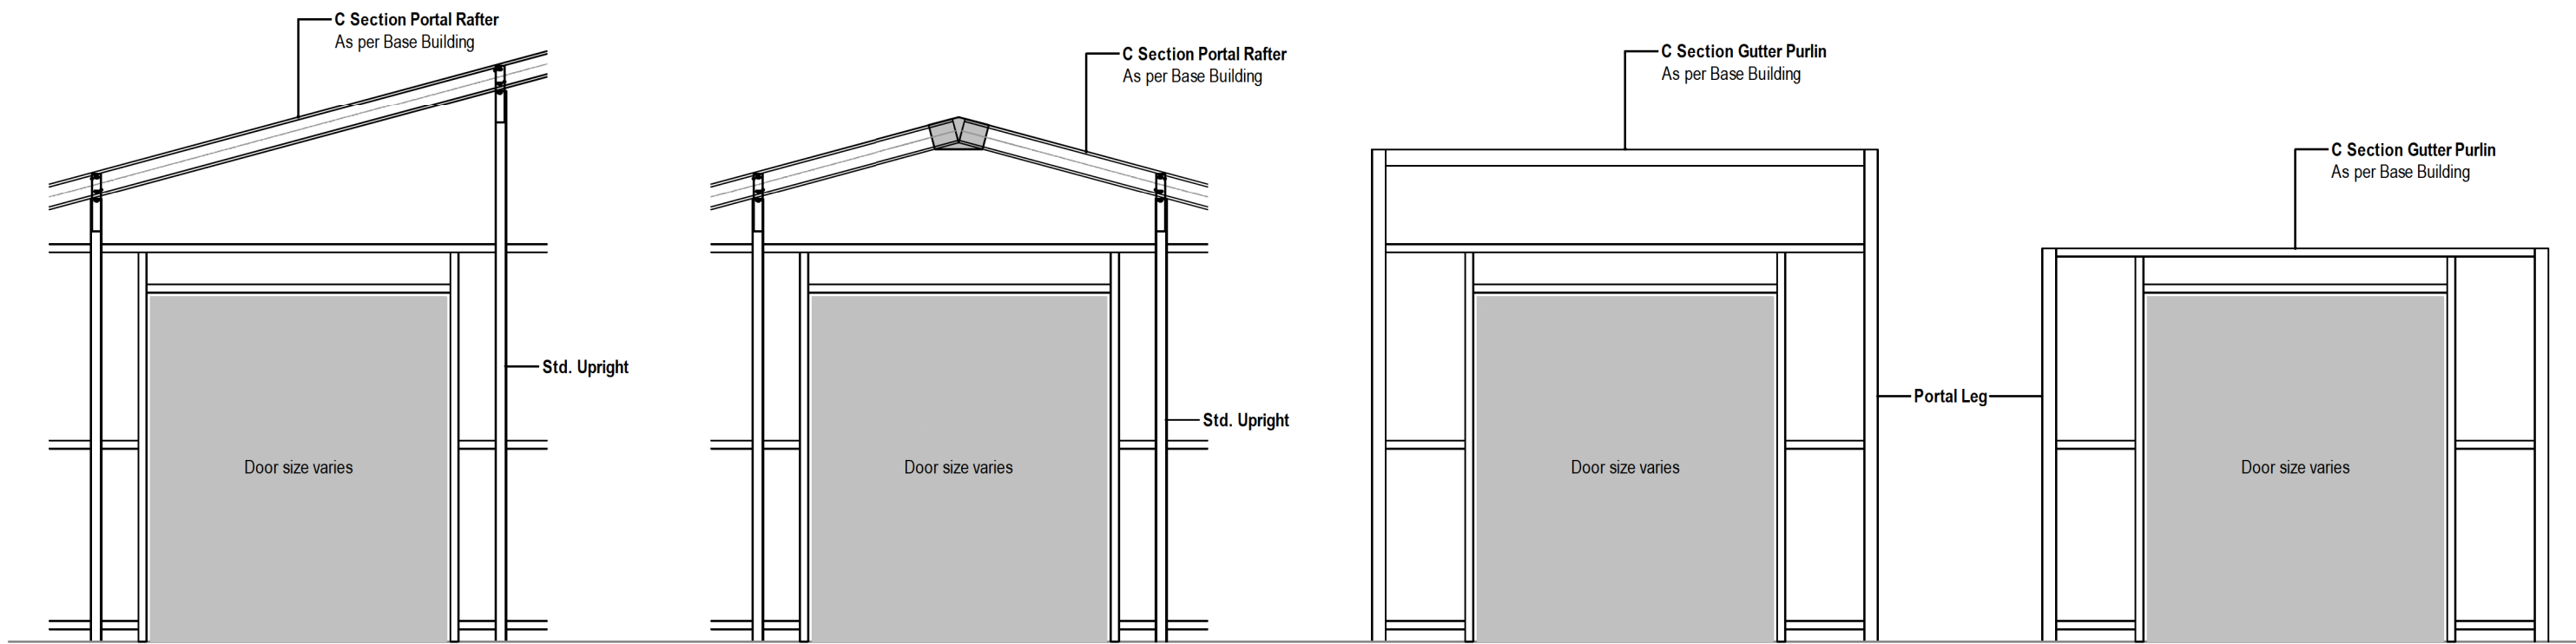

APPROVED
BC210007
22/02/2021
Andrew Nichols
Page 16 of 34
Central Hawkes Bay
District Council

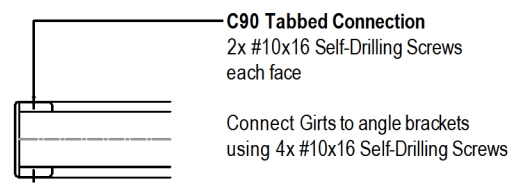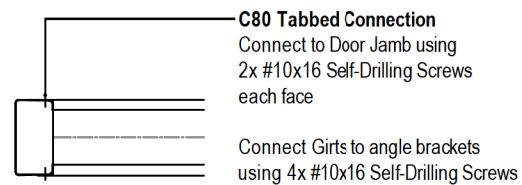

C SECTION TABBED CONNECTION
 SCALE 1:10

C SECTION NOTCHED CONNECTION
 SCALE 1:10


Project Ref: 1550193
 © Copyright 2017 Spanbild NZ Ltd. All rights reserved.

Nathan Tritt
 300 Homewood Road
 Otane 4277
 0272031205



Gable Range - Design

Minor Door Openings SD-M05

Sheet 17 of 20

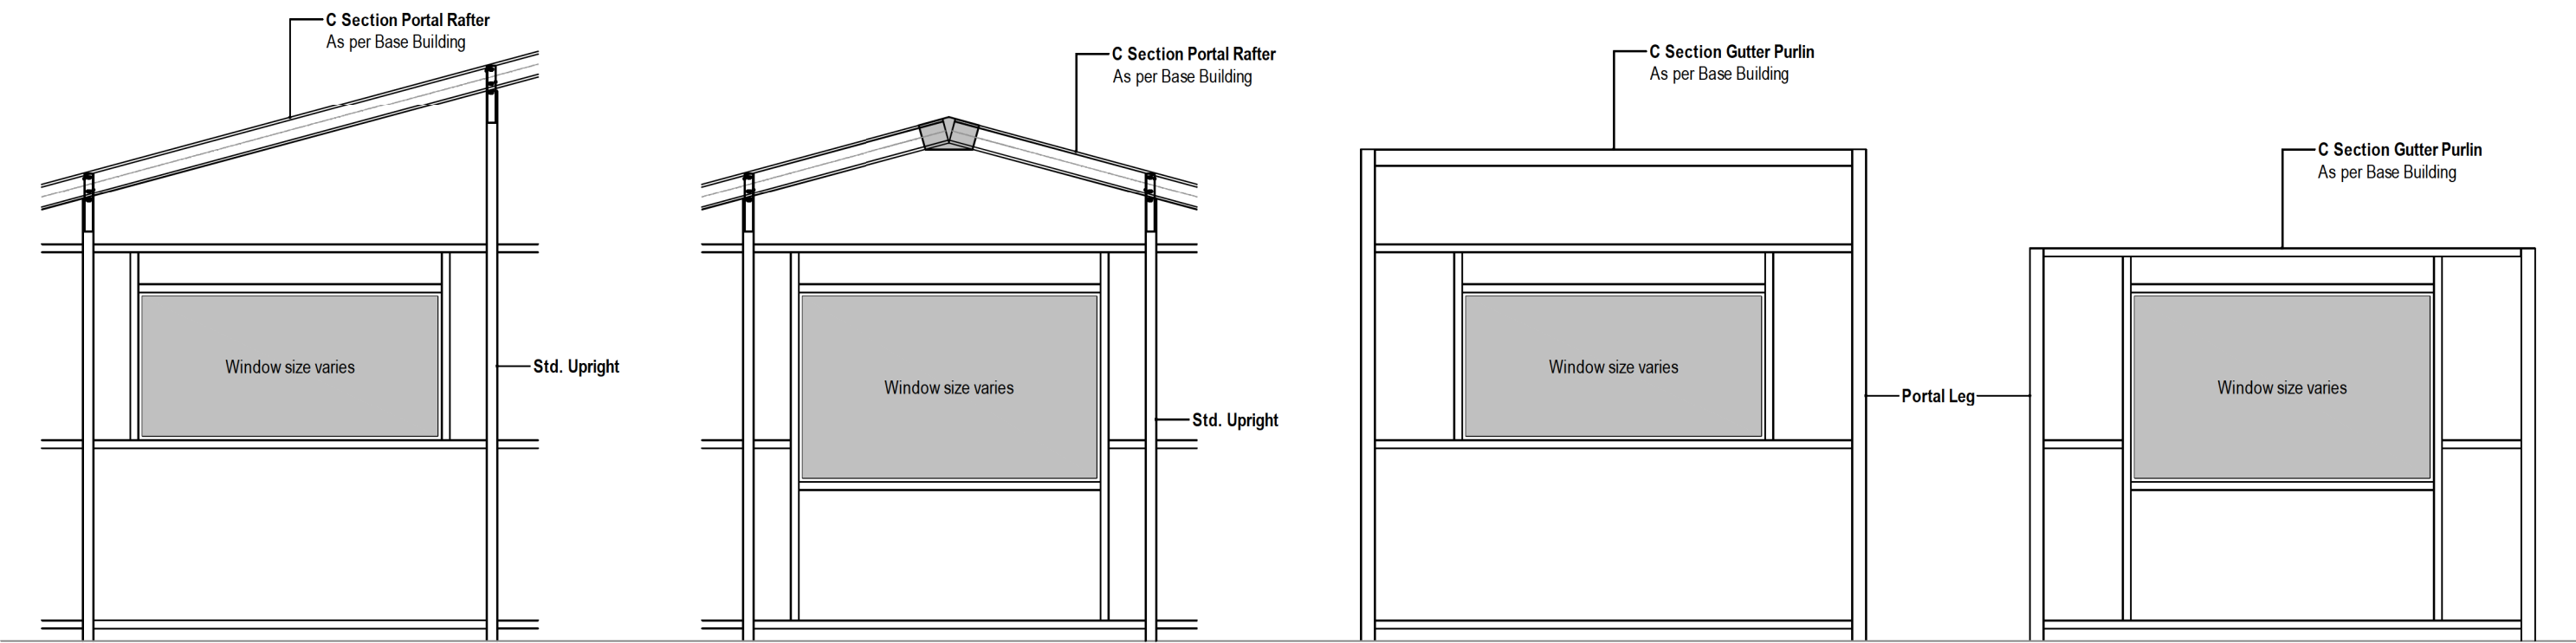


APPROVED
BC210007
22/02/2021
Andrew Nichols
Page 17 of 34
Central Hawkes Bay
District Council

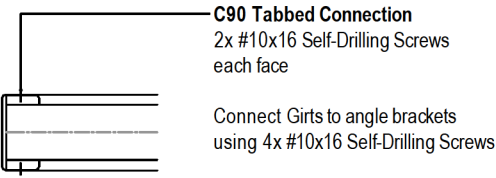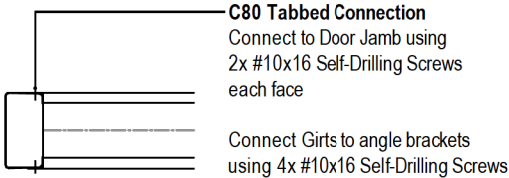

C SECTION TABBED CONNECTION
 SCALE 1:10

C SECTION NOTCHED CONNECTION
 SCALE 1:10



Project Ref: 1550193

© Copyright 2017 Spanbild NZ Ltd. All rights reserved.

Nathan Tritt
 300 Homewood Road
 Otane 4277
 0272031205


Gable Range - Design

Minor Window Openings SD-M06

Sheet 18 of 20


APPROVED
BC210007
22/02/2021
Andrew Nichols
Page 18 of 34
Central Hawkes Bay
District Council

PAGE INTENTIONALLY LEFT BLANK

	
Project Ref: 1550193	
© Copyright 2017 Spanbild NZ Ltd. All rights reserved.	
Nathan Tritt 300 Homewood Road Otane 4277 0272031205	
Gable Range	
Flashing Details	
Sheet 19 of 20	

PAGE INTENTIONALLY LEFT BLANK

APPROVED
BC210007
22/02/2021
Andrew Nichols
Page 19 of 34
Central Hawkes Bay
District Council



Project Ref: 1550193

© Copyright 2017 Spanbild NZ Ltd. All rights reserved.


Nathan Tritt
300 Homewood Road
Otane 4277
0272031205


Gable Range


Flashing Detail SD-E01

Sheet 20 of 20

APPROVED
BC210007
22/02/2021
Andrew Nichols
Page 20 of 34
Central Hawkes Bay
District Council

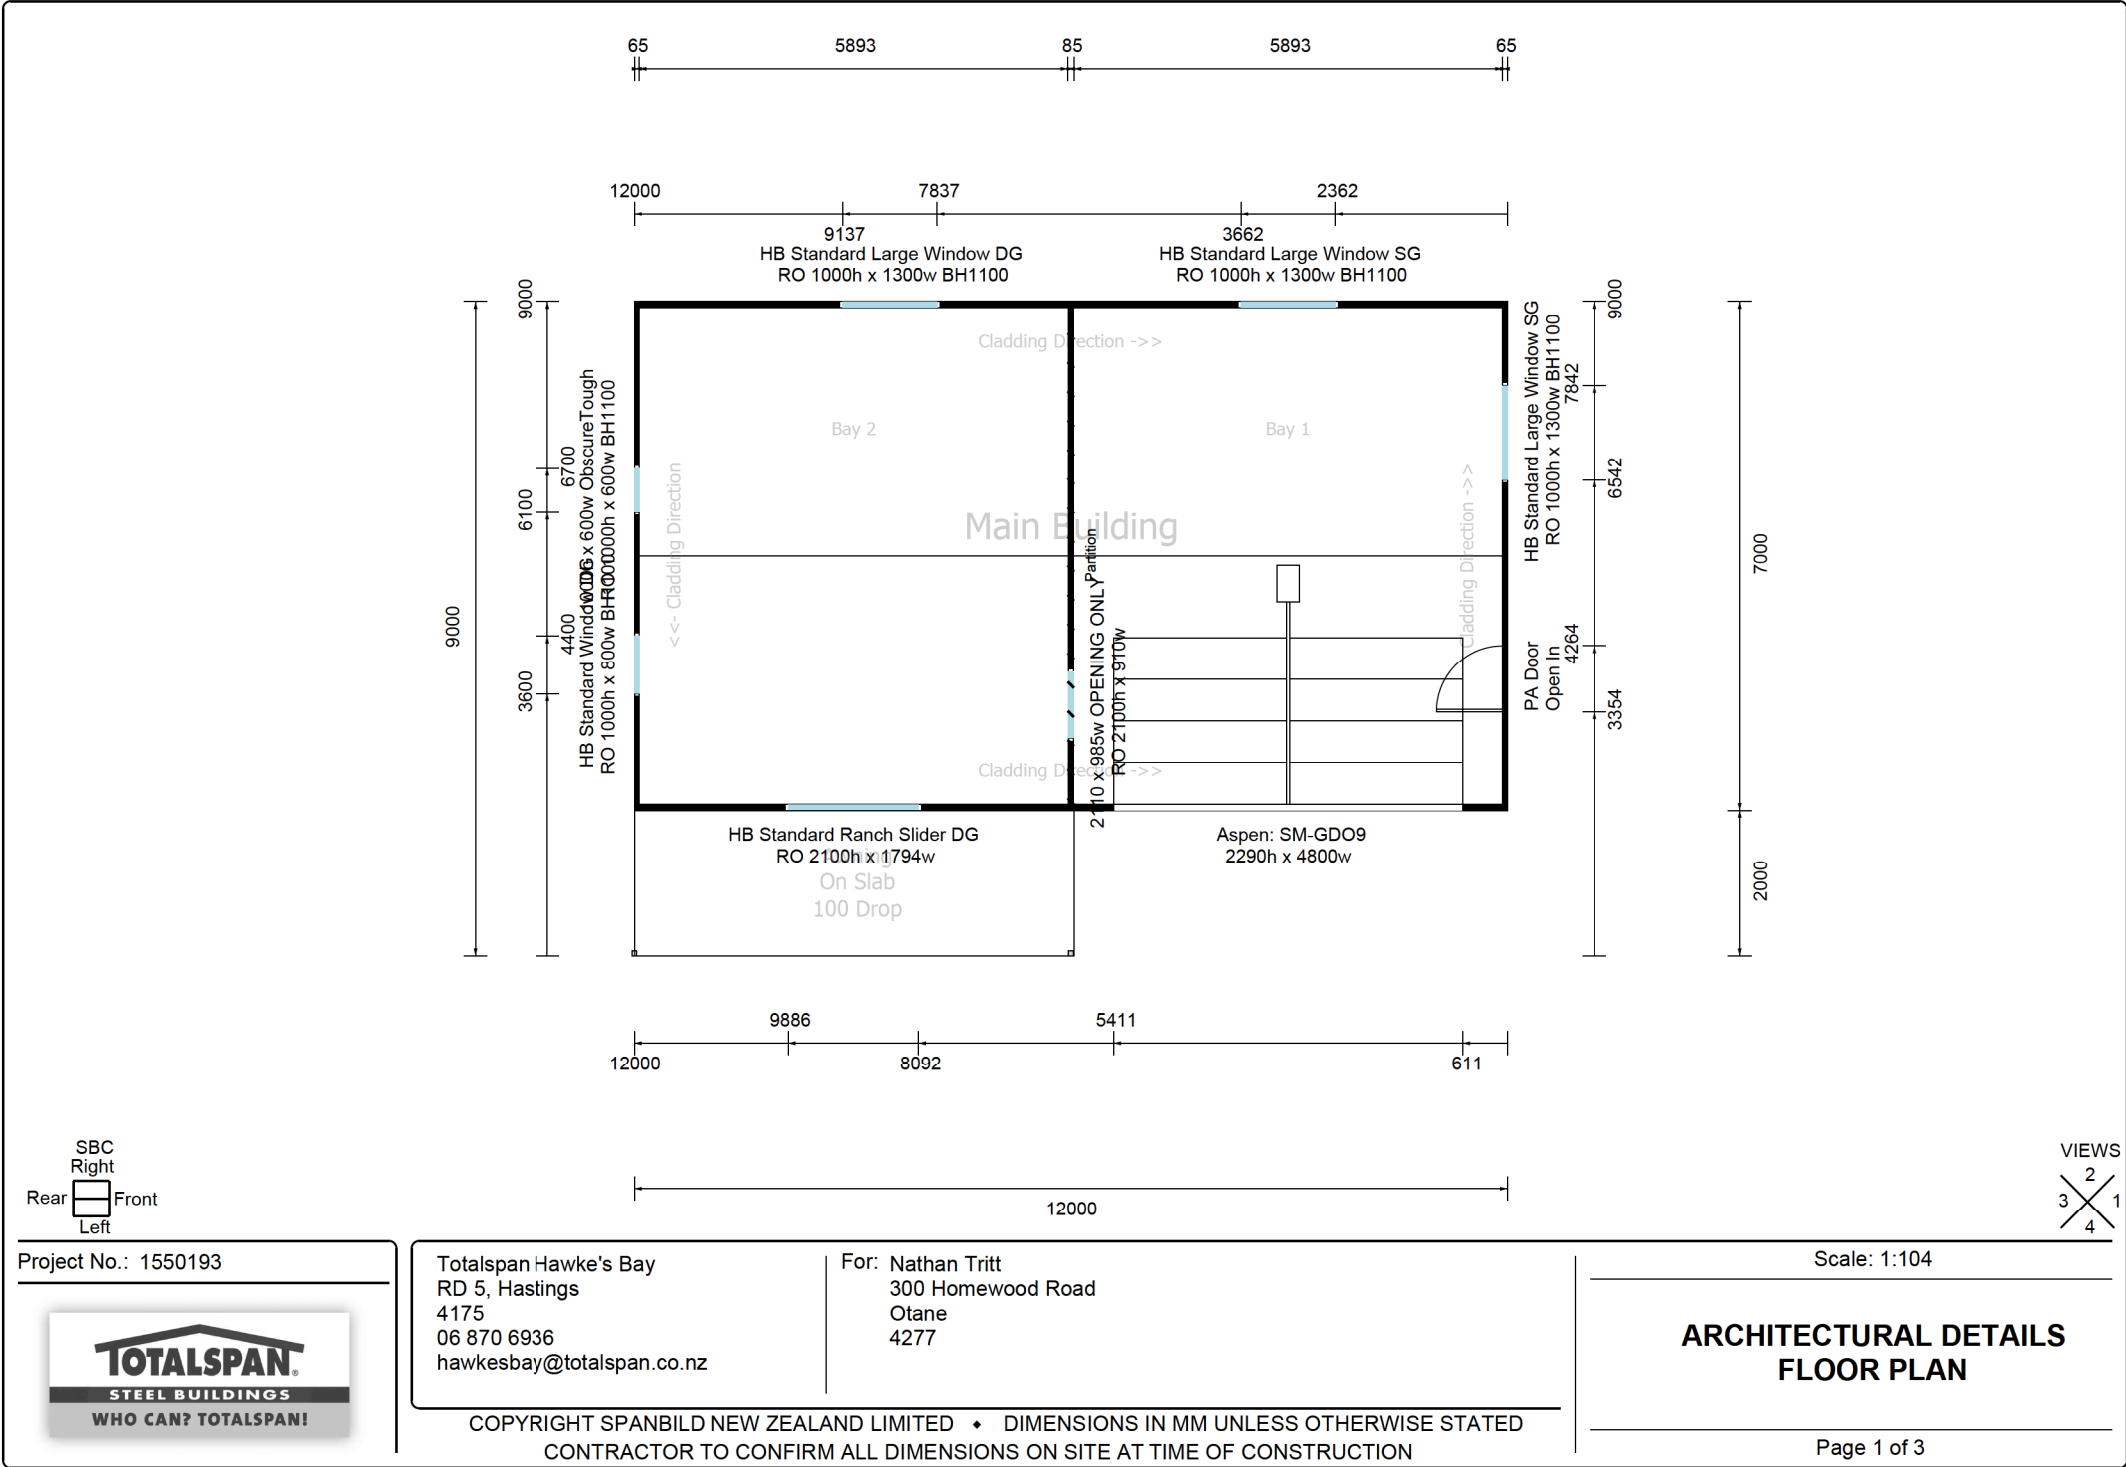

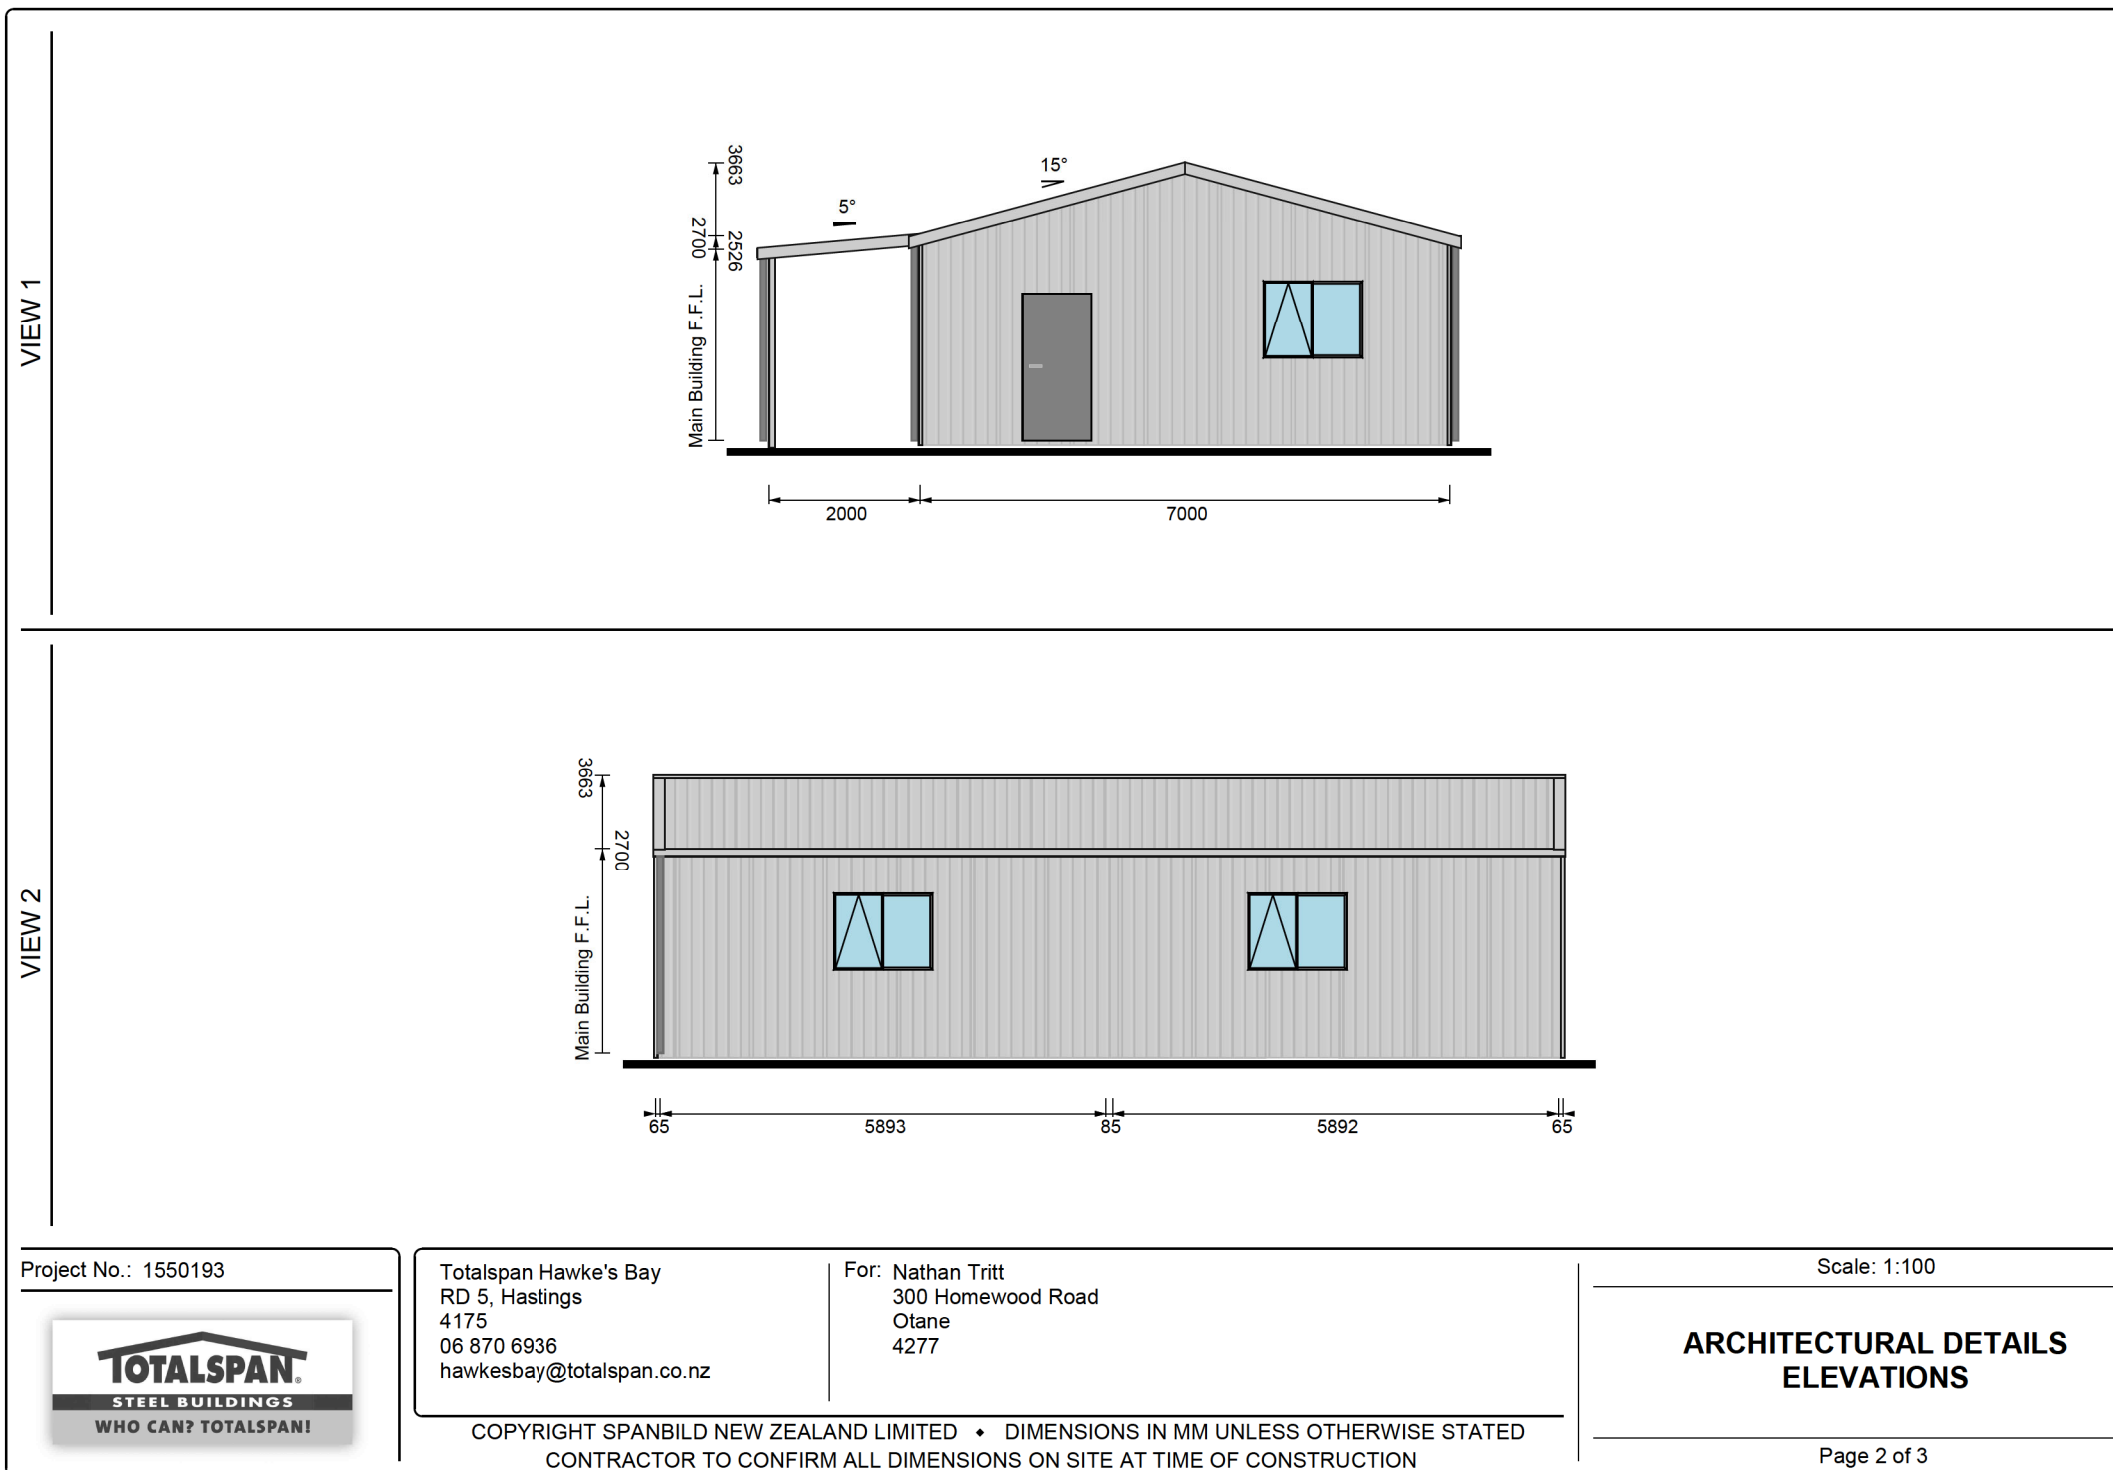

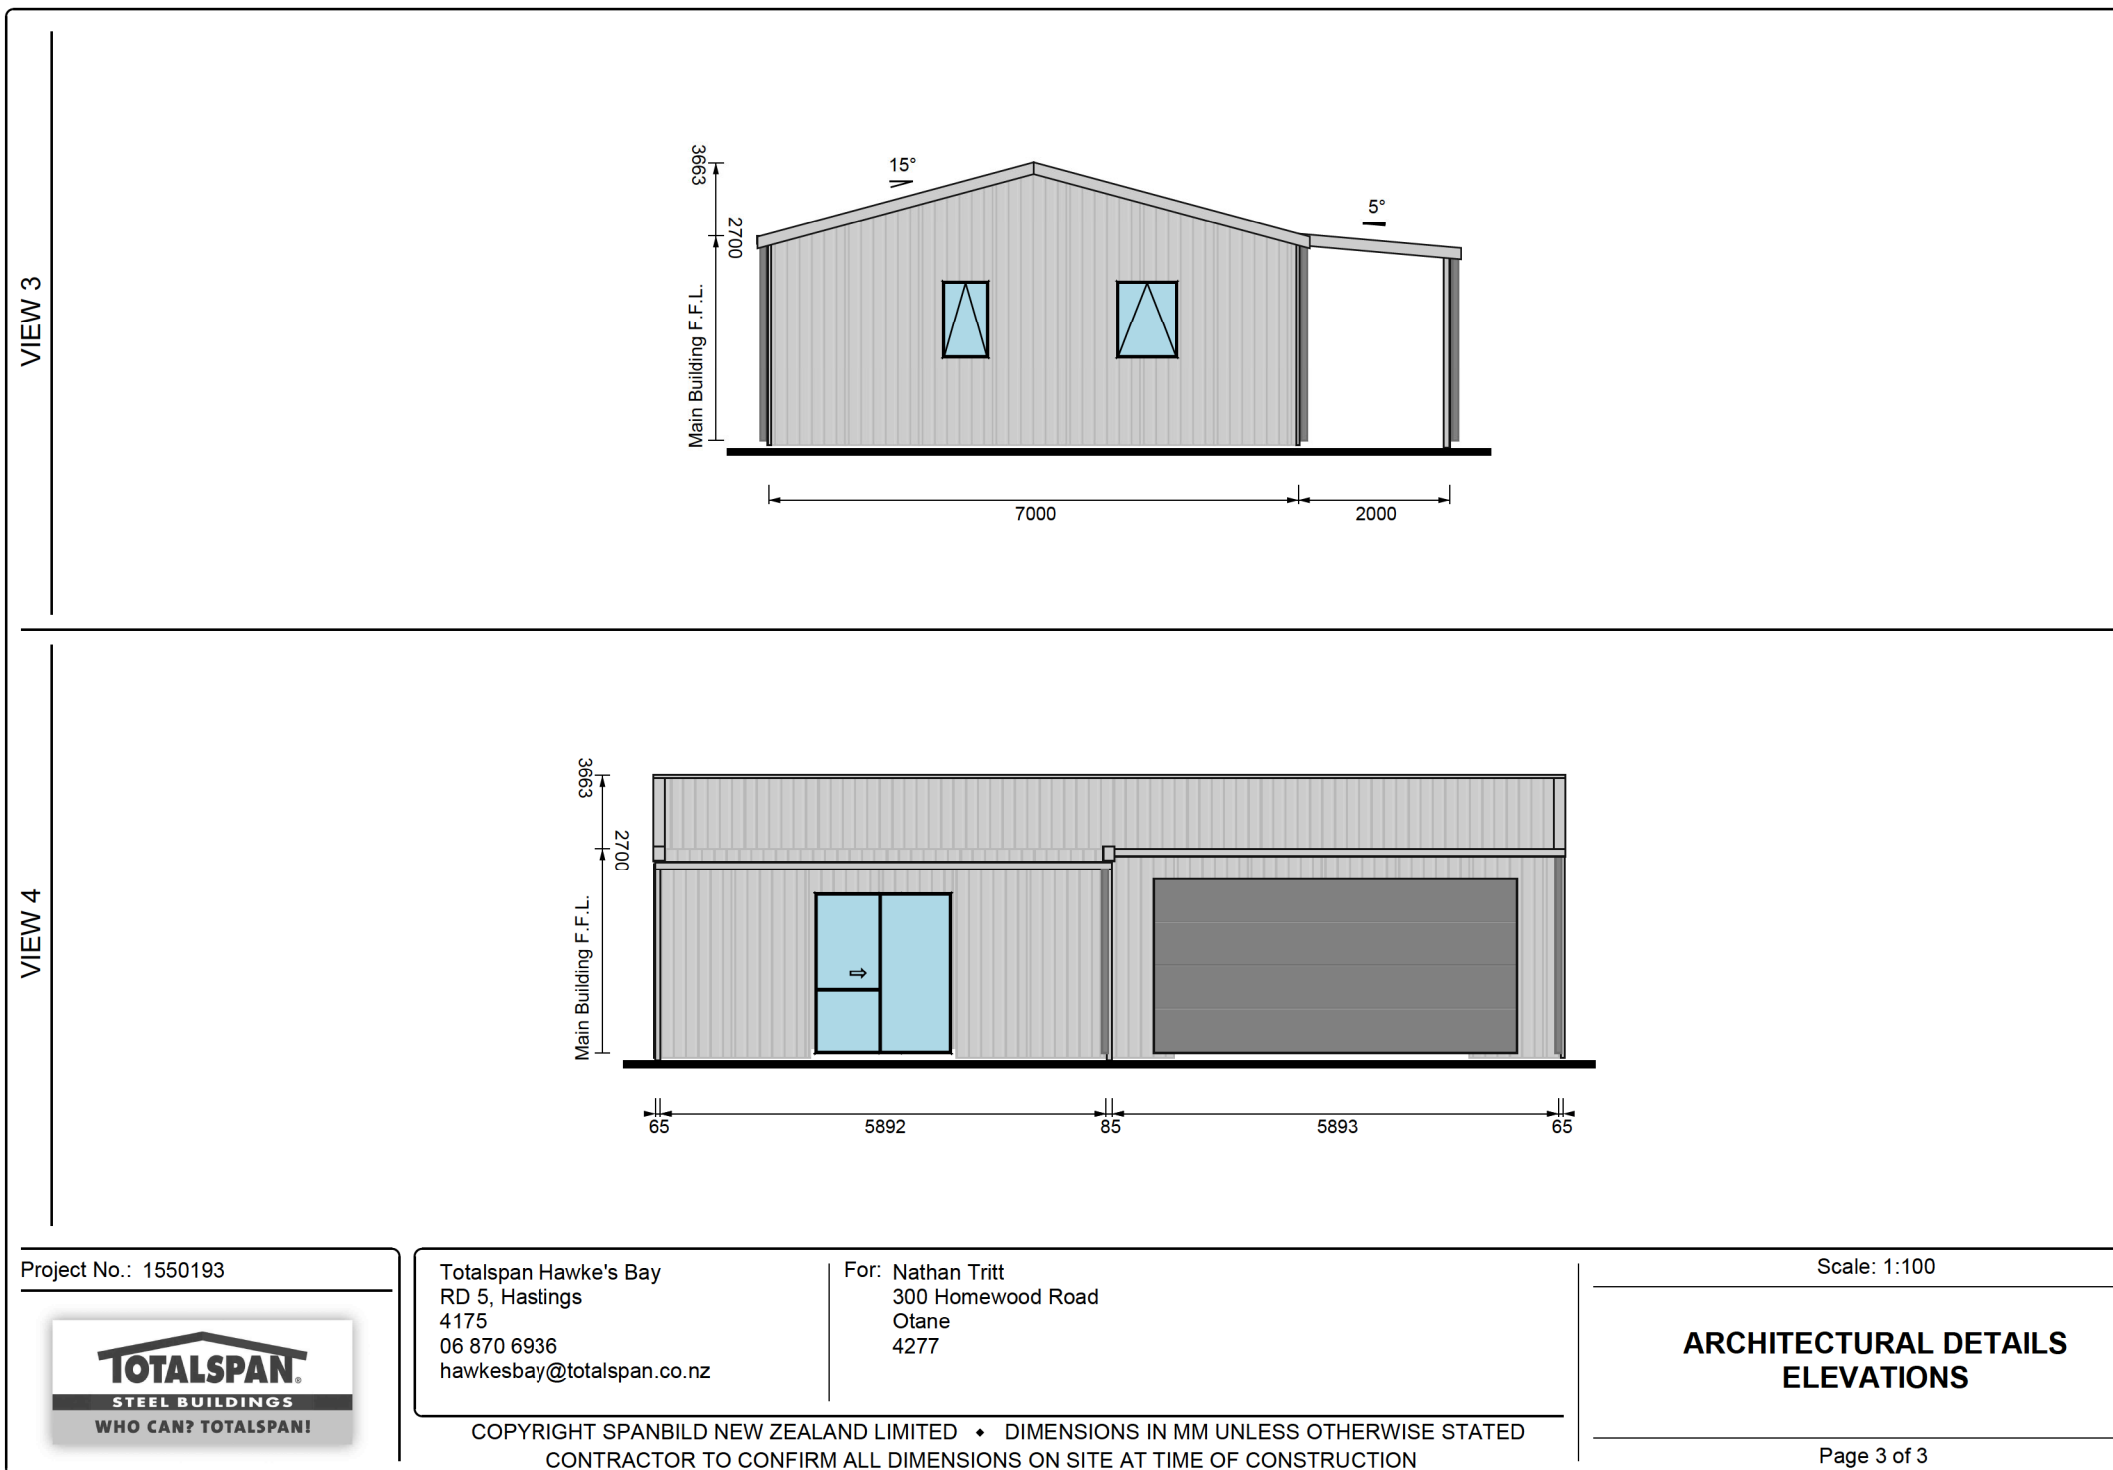

pak design

ARCHITECTURAL DESIGNERS


8 Connolly Place, Milson, Palmerston North 4414
P: 06 350 3902 C: 027 204 9423
E: office@pakdesign.co.nz W: www.pakdesign.co.nz
COPYRIGHT © ALL RIGHTS RESERVED

TRITT Sleepout

300 Homewood Rd, Waipawa

CONTENTS:

L101	Location & Site Plans	R1
L102	Floor Finishes Plan	R1
L103	Drainage Plan	R1
L104	Roof Drainage Plan	R1
L105	Electrical Layout	R1

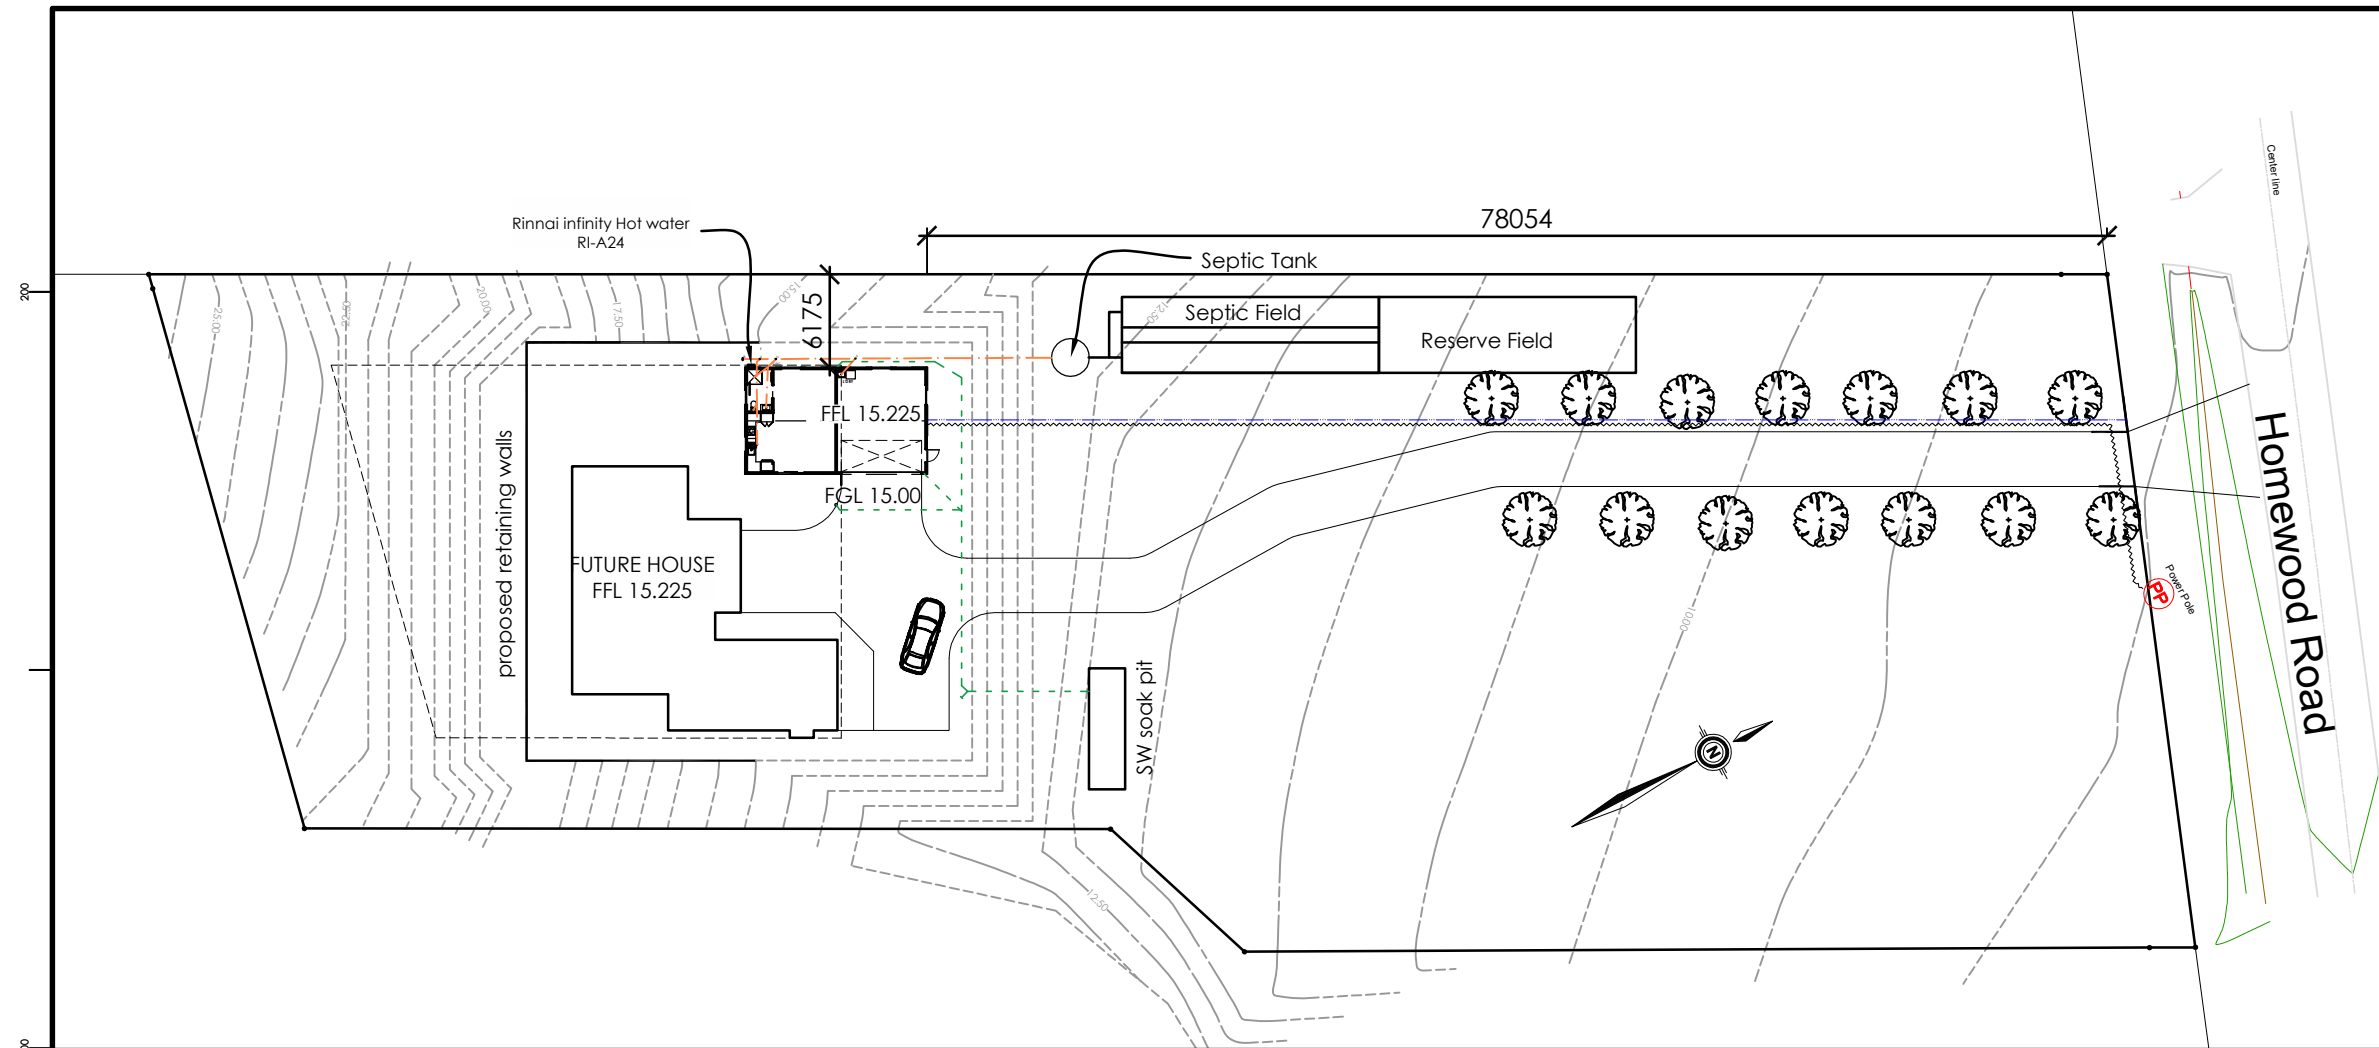


ALL BUILDING LEVELS TO BE CONFIRMED ON SITE.

- FINISHED FLOOR LEVEL MUST BE A MINIMUM OF 225mm ABOVE UNSEALED GROUND & 150mm ABOVE PERMANENT PAVING
- WHERE THE STEP DOWN HEIGHT AT ANY EXTERNAL DOOR EXCEEDS 190mm, A CONCRETE STEP OR STEPS IS TO BE CONSTRUCTED WITH A MAXIMUM RISE OF 190mm AND A MIN TREAD OF 280mm

TEMPORARY SITE FENCING

Temporary site fencing to be constructed around the building site to stop public access. An acceptable fence may be constructed with galvanised chain link netting having a max sized grid of 50mm x 50mm. Post spacing shall be a maximum of 2.5 m, and the gap between the bottom of the fence and ground no greater than 100 mm. NZBC F5 AS/1

Wind Zone: Extra High
Earthquake Zone: Zone 3
Exposure Zone: Zone B
Subsoil classification: Class D
District Plan Zone: Residential
Building Category: IV
Residential
Floor Loadings: 2kPa

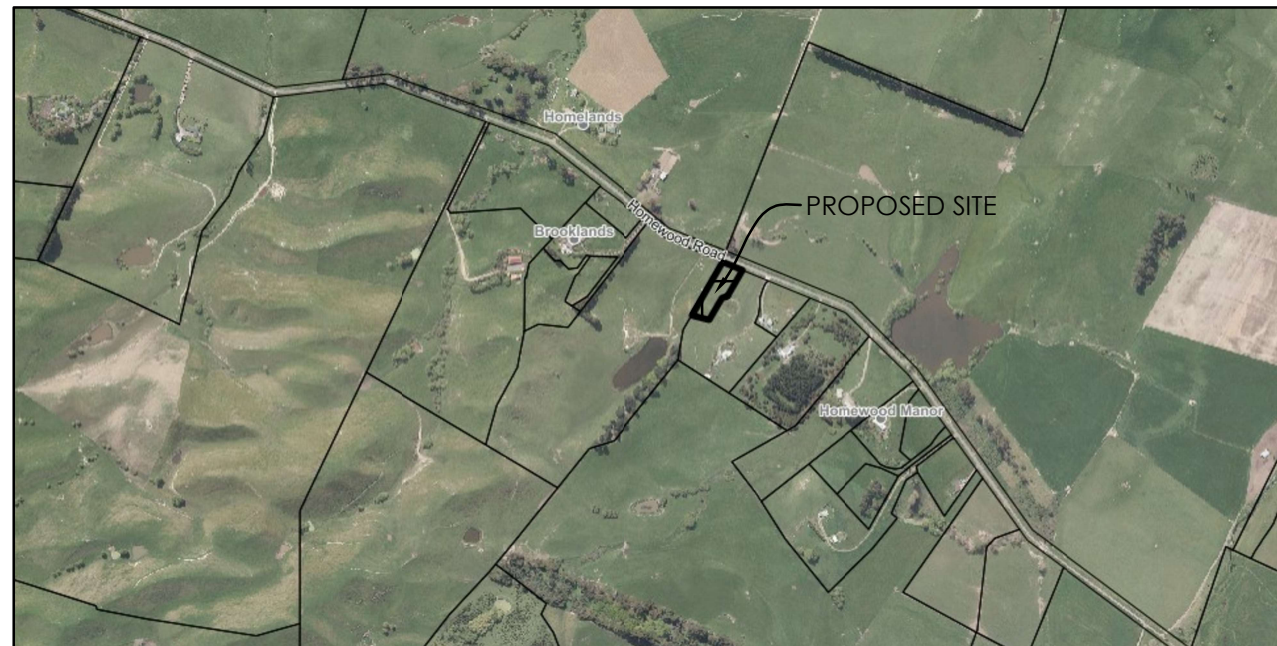

APPROVED
BC210007
22/02/2021
Andrew Nichols
Page 23 of 34
Central Hawkes Bay
District Council

1) ALL DIMENSIONS TO BE CONFIRMED ON SITE BY CONTRACTOR BEFORE MANUFACTURE / CONSTRUCTION. DO NOT SCALE OFF DRAWINGS. NOTIFY DESIGNER IMMEDIATELY OF ANY DISCREPANCIES.
2) THESE DRAWINGS MUST BE READ IN CONJUNCTION WITH ALL SPECIFICATIONS, ENGINEER & SUB-CONSULTANCE DOCUMENTATION & TRADE RELATED PUBLICATIONS. CONSTRUCT IN ACCORDANCE WITH THE NEW ZEALAND BUILDING CODE & OTHER STATUTORY, REGULATORY DOCUMENTS & TERRITORIAL AUTHORITY REQUIREMENTS.

REV	DATE	AMENDMENT
1	16.12.20	CONSENT ISSUE

DRAWING TITLE:


Location & Site Plan

DATE:	16-Dec-20	JOB #:	20030
DESIGNED:	MCJ	DRAWN:	MCJ
ISSUE:	Consent	CHECKED:	MCJ

SCALE:	A3 @ 1:500	DRAWING #:	REV:
		L101	R1

The diagram is a detailed architectural floor plan of a 'Main Building' divided into 'Bay 1' and 'Bay 2'. The building is 12,000 units wide and 9,000 units high. Key features include:

- Windows:**
 - Top Bay 1: HB Standard Large Window SG (RO 1000h x 1300w BH1010).
 - Top Bay 2: HB Standard Large Window DG (RO 1000h x 1300w BH1010).
 - Bottom Bay 1: Aspen: SM-GDO9 (2290h x 4800w).
 - Bottom Bay 2: HB Standard Ranch Slider DG (RO 2100h x 1794w) with 'On Slab 100 Drop'.
 - Left Wall: HB Standard Window DG (RO 1000h x 600w Obscure Tough) and HB Standard Window DG (RO 1000h x 800w BH1010).
 - Right Wall: HB Standard Large Window SG (RO 1000h x 1300w BH1010).
- Doors:**
 - Bottom Bay 1: PA Door Open In (4264).
 - Bottom Bay 2: 2110 x 985w OPENING ONLY Partition (RO 2100h x 910w).
- Other Features:**
 - Grade A Safety Glass as per NZS4223.3 in both bays.
 - Cladding Direction arrows pointing right (>>) and left (<<).
 - Dimensions: Overall width 12,000; overall height 9,000. Internal dimensions include 9,886, 5,411, 6,11, 8,092, 12,000, 9,886, 5,411, 6,11, 8,092, 12,000, 9,886, 5,411, 6,11, 8,092, 12,000.

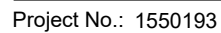


Scale: 1:104

Page 1 of 3




VIEW 1

APPROVED
BC210007
22/02/2021
Andrew Nichols
Page 25 of 34
Central Hawkes Bay
District Council

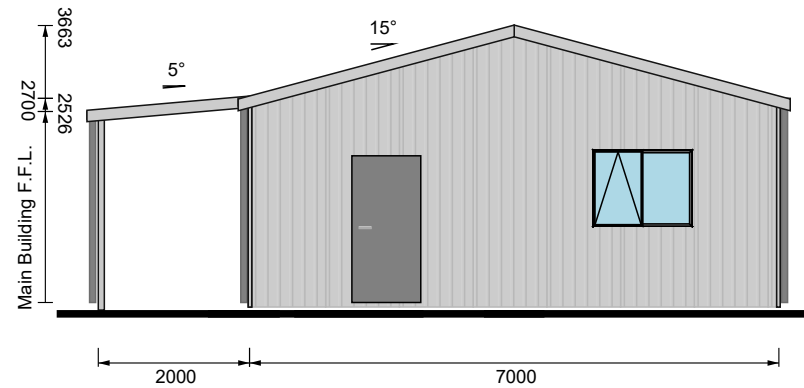

RISK MATRIX						
Risk factor	Risk severity				subtotals	
	low	med	high	v-high		
Wind zone	0	0	1	2	✓	2
No. of storeys	0	✓	1	2	4	0
Roof/wall intersection design	0	1	✓	3	5	1
Eaves width	0	1	2	✓	5	2
Envelope complexity	0	✓	1	3	6	0
Deck design	0	✓	2	4	6	0
Total risk score:						5

VIEW 2

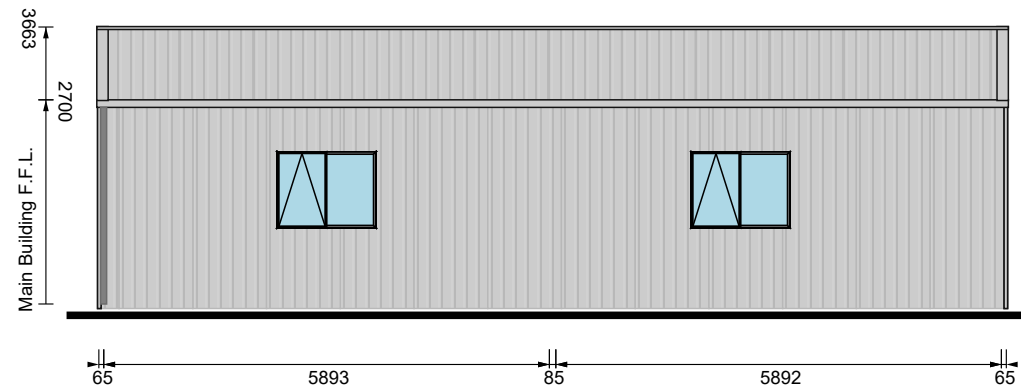

RISK MATRIX						
Risk factor	Risk severity				subtotals	
	low	med	high	v-high		
Wind zone	0	0	1	2	✓	2
No. of storeys	0	✓	1	2	4	0
Roof/wall intersection design	0	1	✓	3	5	1
Eaves width	0	1	2	✓	5	2
Envelope complexity	0	✓	1	3	6	0
Deck design	0	✓	2	4	6	0
Total risk score:						5

Project No.: 1550193



Totalspan Hawke's Bay
 RD 5, Hastings
 4175
 06 870 6936
 hawkesbay@totalspan.co.nz

For: Nathan Tritt
 300 Homewood Road
 Otane
 4277


Scale: 1:100

ARCHITECTURAL DETAILS ELEVATIONS


COPYRIGHT SPANBILD NEW ZEALAND LIMITED • DIMENSIONS IN MM UNLESS OTHERWISE STATED
 CONTRACTOR TO CONFIRM ALL DIMENSIONS ON SITE AT TIME OF CONSTRUCTION

Page 2 of 3

APPROVED
BC210007
22/02/2021
Andrew Nichols
Page 26 of 34
Central Hawkes Bay
District Council

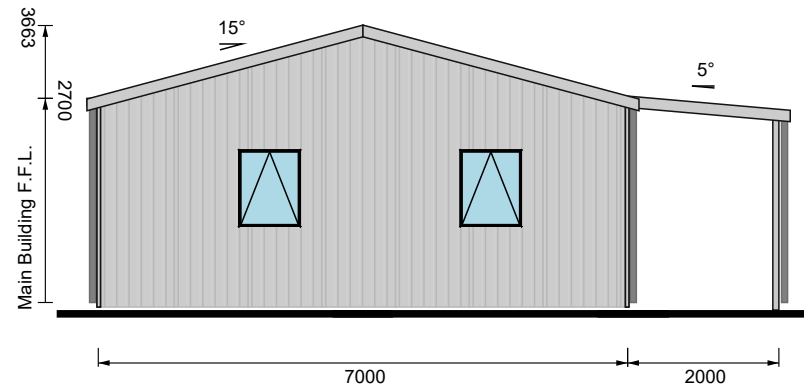

RISK MATRIX						
	Risk severity					
Risk factor	low	med	high	v-high		subtotals
Wind zone	0	0	1	2	✓	2
No. of storeys	0	✓	1	2	4	0
Roof/wall intersection design	0	1	✓	3	5	1
Eaves width	0	1	2	✓	5	2
Envelope complexity	0	✓	1	3	6	0
Deck design	0	✓	2	4	6	0
Total risk score:						5

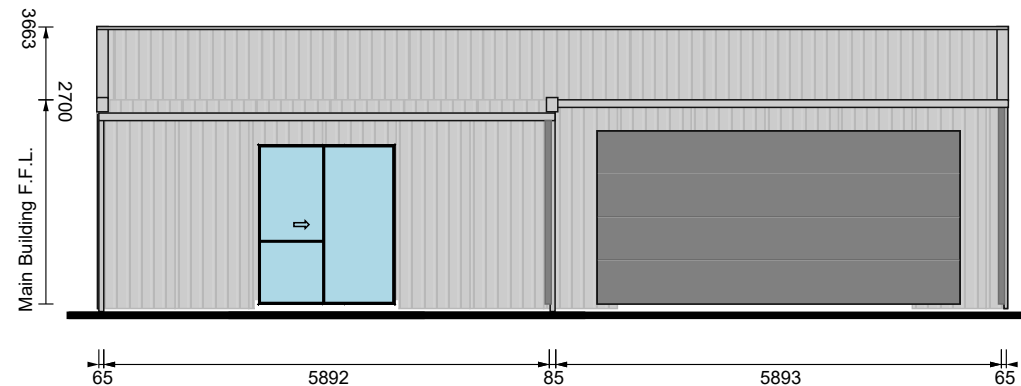

RISK MATRIX						
	Risk severity					
Risk factor	low	med	high	v-high		subtotals
Wind zone	0	0	1	2	✓	2
No. of storeys	0	✓	1	2	4	0
Roof/wall intersection design	0	1	✓	3	5	1
Eaves width	0	1	2	✓	5	2
Envelope complexity	0	✓	1	3	6	0
Deck design	0	✓	2	4	6	0
Total risk score:						5

Project No.: 1550193



Totalspan Hawke's Bay
 RD 5, Hastings
 4175
 06 870 6936
 hawkesbay@totalspan.co.nz


For: Nathan Tritt
 300 Homewood Road
 Otane
 4277

Scale: 1:100

ARCHITECTURAL DETAILS ELEVATIONS

COPYRIGHT SPANBILD NEW ZEALAND LIMITED • DIMENSIONS IN MM UNLESS OTHERWISE STATED
 CONTRACTOR TO CONFIRM ALL DIMENSIONS ON SITE AT TIME OF CONSTRUCTION

APPROVED
BC210007
22/02/2021
Andrew Nichols
Page 27 of 34
Central Hawkes Bay
District Council

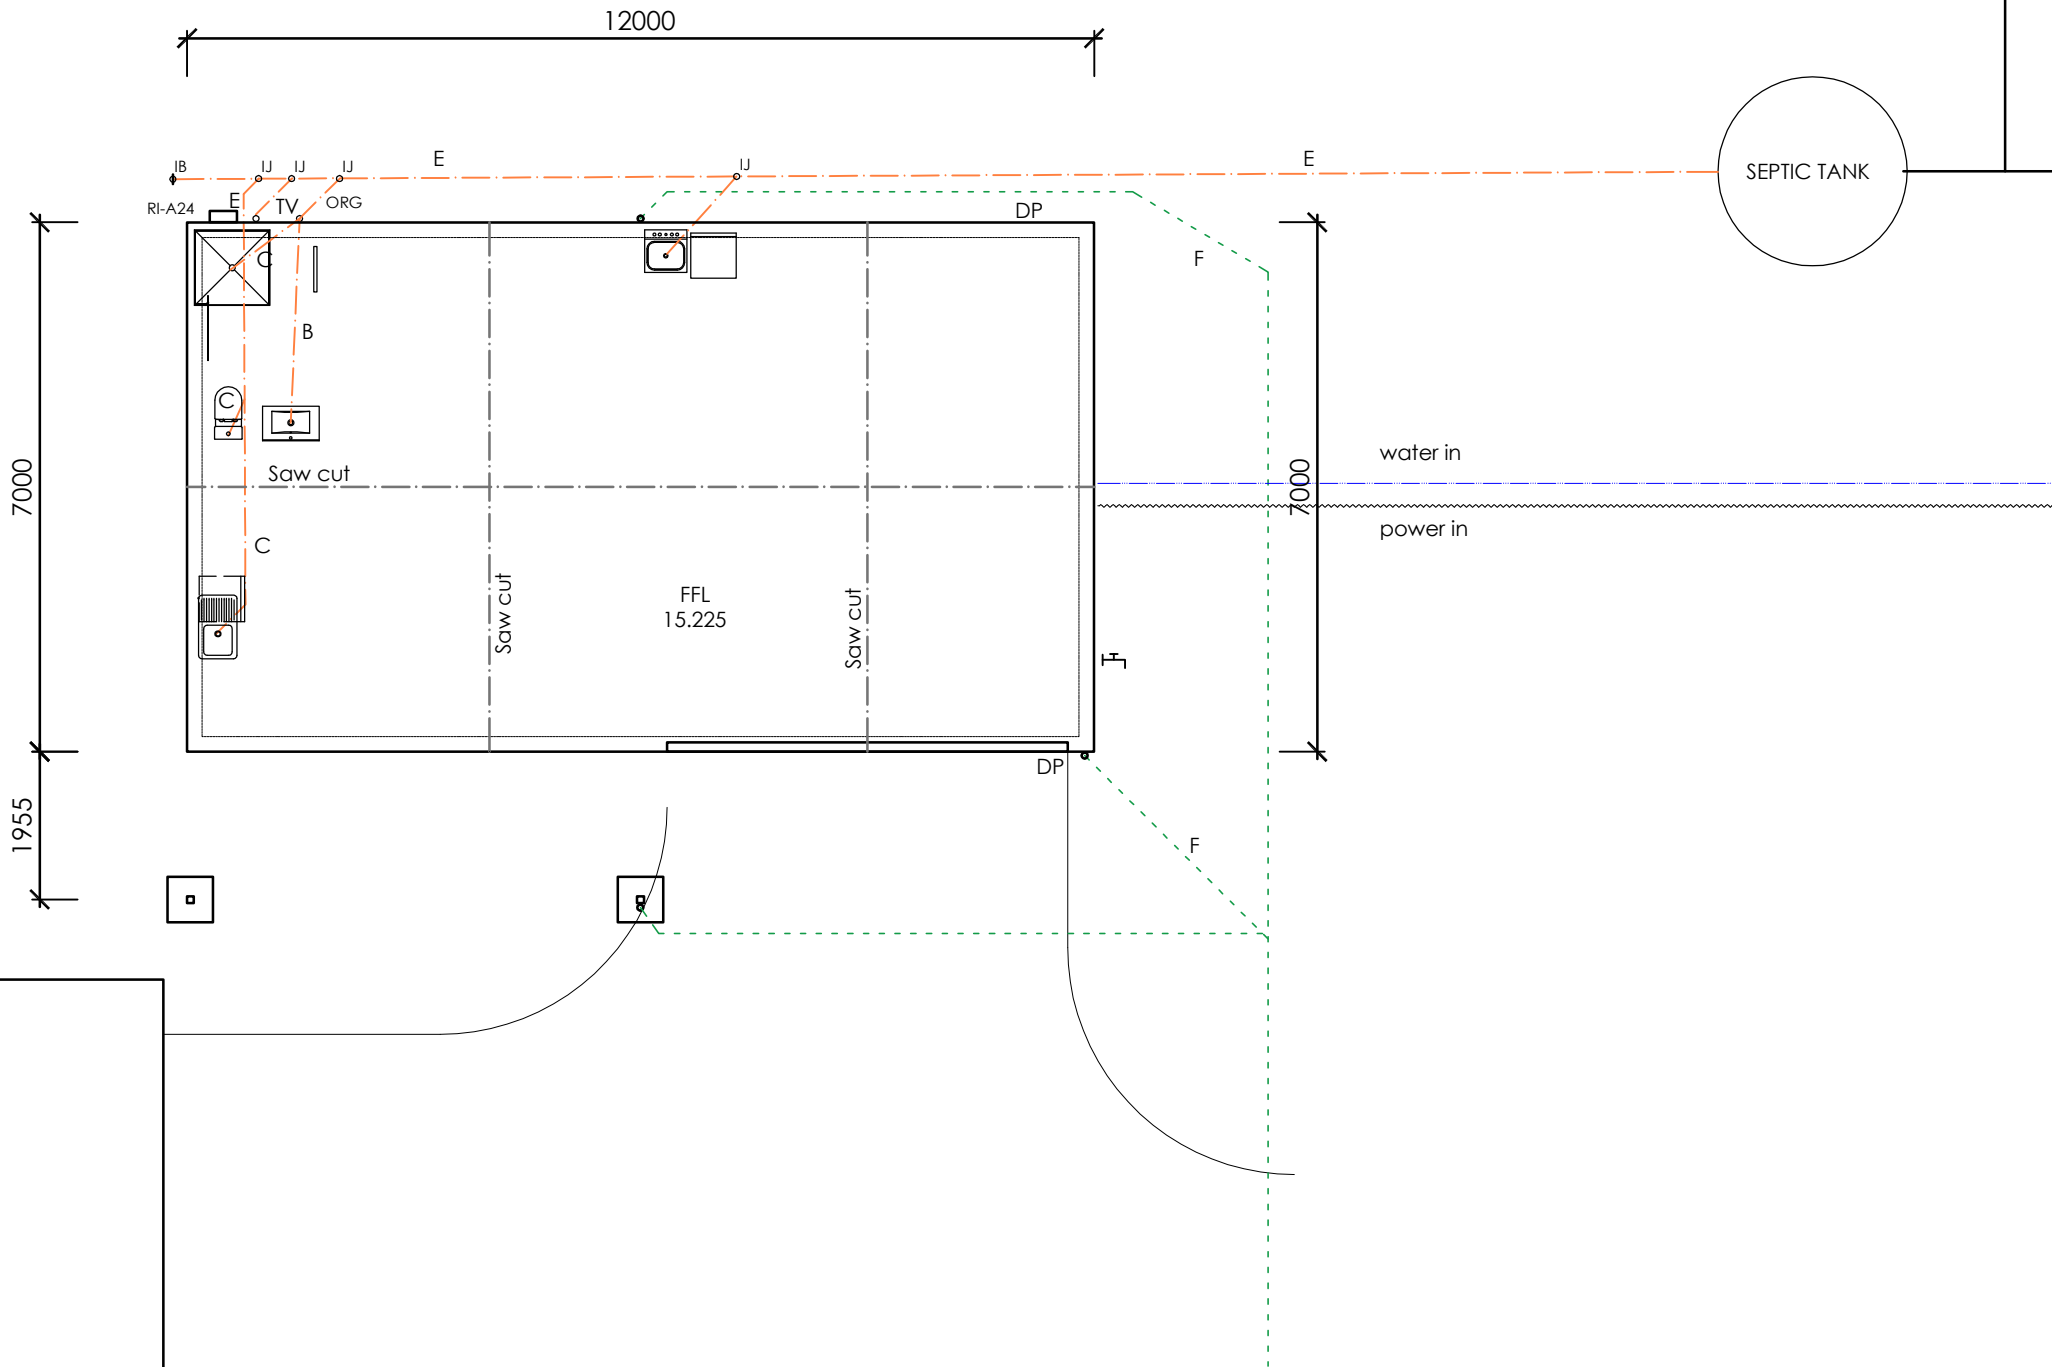

All pipework to be separated from the foundation by a minimum gap of 25mm. pipework must also be sleeved where it passes through the concrete slab or concrete footings to allow expansion & contraction of the pipe

1. Execute and complete all plumbing & drainage requirements in accordance with AS3500 & E1/AS1
2. Hot & Cold water supply pipe sizing MD16 & 20.
3. For Sinks Over 3.5m away from crown of water trap an AAV is a viable solution for pressure regulation.
4. Insulate lagging to the first 3m of the hot water pipe

1. To limit the growth of Legionella bacteria the control thermostat on the water storage heater to be set at a temperature NO less than 60°C
2. A tempering valve to be installed to limit the water supply at any fixture or fitting to be a maximum of 55°

ORG	Gully Trap	A	= 32Ø to 1:40 fall min
IJ	Inspection Junction	B	= 40Ø to 1:40 fall min
IB	Inspection Bend	C	= 80Ø to 1:60 fall min
IV	Isolation Valve		
TV	80Ø Terminal Vent	E	= 100Ø to 1:60 fall min
DP	Down Pipe		foul water drain
ET	Brass Exterior Taps	F	= 100Ø to 1:100 fall min
AP	Access point		stormwater drain

A = 32Ø to 1:40 fall min
B = 40Ø to 1:40 fall min
C = 80Ø to 1:60 fall min

E = 100Ø to 1:60 fall min
 foul water drain
F = 100Ø to 1:100 fall min
 stormwater drain

The developed length of the pipe-run from the water heater to the kitchen sink outlet shall be minimized, Table 5 (below) provides acceptable maximum pipe lengths. Where the pip supplying the sink unit is composed of sections of different diameters, the total volume of water in the pipe run shall not exceed 2 litres.

Nominal Pipe Size (mm)	10
Length (m)	25

Nominal Pipe Size (mm)	10
Length (m)	25

1) ALL DIMENSIONS TO BE CONFIRMED ON SITE BY CONTRACTOR BEFORE MANUFACTURE / CONSTRUCTION. DO NOT SCALE OFF DRAWINGS. NOTIFY DESIGNER IMMEDIATELY OF ANY DISCREPANCIES.

2) THESE DRAWINGS MUST BE READ IN CONJUNCTION WITH ALL SPECIFICATIONS, ENGINEER & SUB-CONSULTANCE DOCUMENTATION & TRADE RELATED PUBLICATIONS. CONSTRUCT IN ACCORDANCE WITH THE NEW ZEALAND BUILDING CODE & OTHER STATUTORY, REGULATORY DOCUMENTS & TERRITORIAL AUTHORITY REQUIREMENTS.

REV	DATE	AMENDMENT
1	16.12.20	CONSENT ISSUE

— ARCHITECTURAL DESIGNERS —


8 Connolly Place, Milson, Palmerston North 4414
P: 06 350 3902 C: 027 204 9423
E: office@pakdesign.co.nz W: www.pakdesign.co.nz
COPYRIGHT © ALL RIGHTS RESERVED

PROJECT:
Tritt Home
Homewood Rd, Wapawa

DRAWING TITLE:
Drainage Plan

DATE:	16-Dec-20	JOB #:	20030
DESIGNED:	MCJ	DRAWN:	MCJ
ISSUE:	Consent	CHECKED:	MCJ
SCALE:	DRAWING #: REV:		
A3 @ 1:100	L103 R1		

NOTE: ALL LIGHTING TO BE CONFIRMED ON SITE BY OWNER WITH ELECTRICAL CONTRACTOR

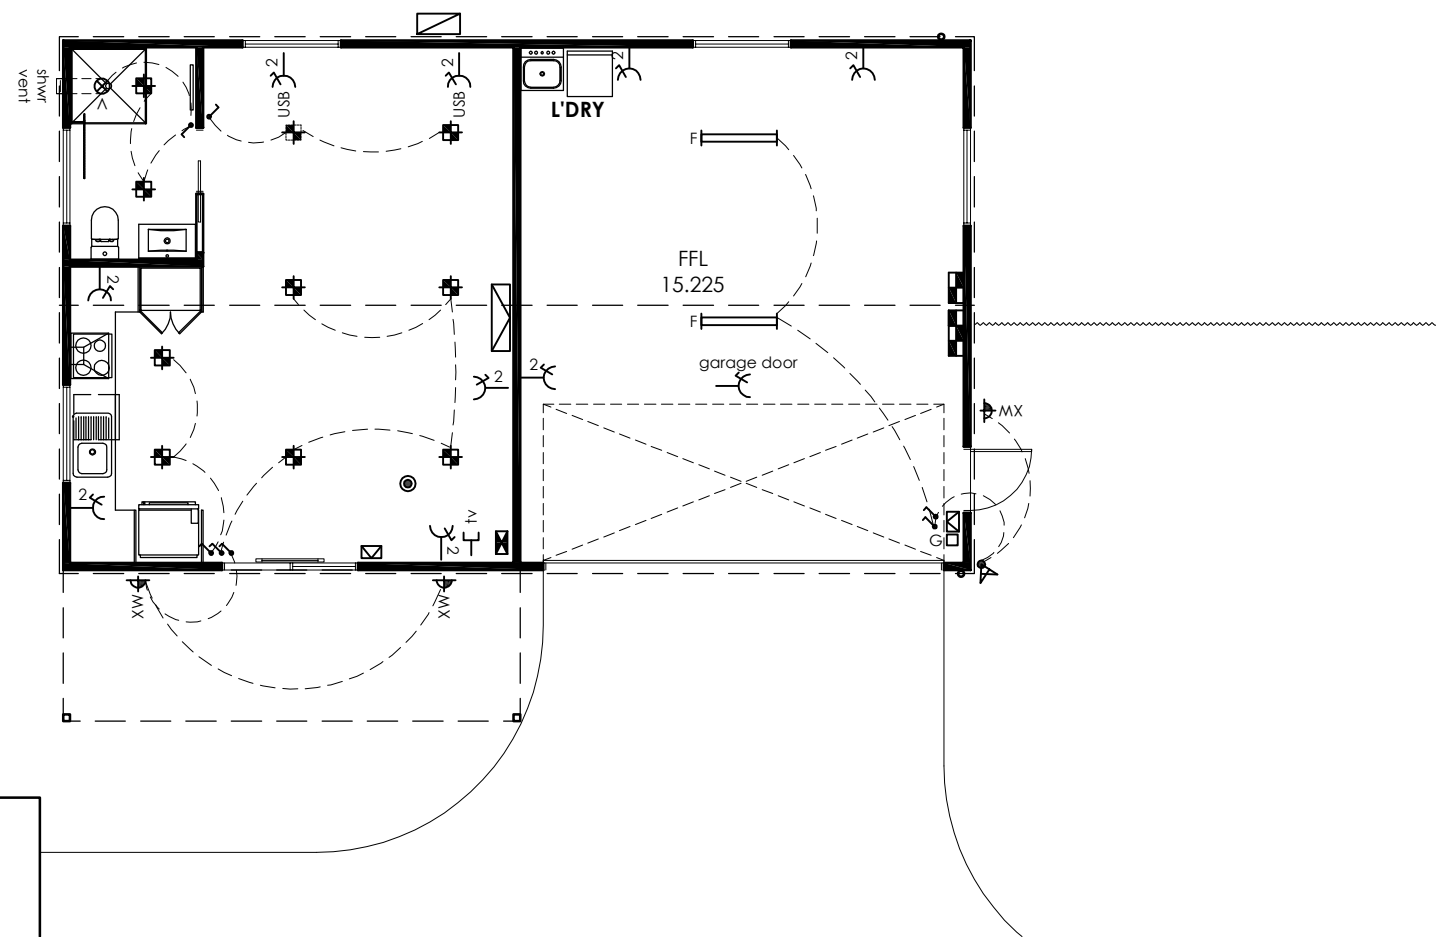

Contractor shall calculate & provide sufficient power cabling to meter board & distribution board to suit loadings, as necessary. Electrical contractor to provide & fit all exterior grills & cowl to range hood ducting. Confirm all final light & power point locations on site with client prior to setting out. Multiple lights are to be run in straight lines, evenly setout. Wire the following kitchen appliances: Oven, Cooktop, Refrigerator, Extraction Hood, & dish washer. provide remote isolation switches for all of the above equipment. locations for remote switches are to be confirmed on site by client, but generally cut & concealed within kitchen cabinetry. Avoid surface mounting conduits. All wiring to be concealed from view. Client to confirm: Sky, Audio, Data, Security, Surround sound system, TV Aerial installation.

ELECTRICAL & LIGHTING LEGEND

	Meter board, proprietary manufactured, zinc plated powder coated metal case or ABS plastic with glazed panel door
	Flush mounted distribution board. provide board complete with all required circuit breakers & RCD protection to all necessary circuits.
	Double socket outlet PDL 600 series white cover plate (height determined on site)
	Single socket outlet PDL 600 series white cover plate (height determined on site) ("RCD" Denote RCD Type socket)
	Single socket outlet PDL 600 series white cover plate (height determined on site) ("RCD" = RCD socket) ("EX" = Exterior)
	Double socket - Double USB outlet
	"PH" Denotes phone / data outlet "TV" Denotes television outlet socket - client to organize decoders as required.
	Garage Door wall mounted control
	Security Sensor
	Security control pad
	Fibre/Telephone Demarc Point with dedicated Power Supply
	Hard wired Smoke Alarm
	High wall heat pump
	Heat pump outdoor unit
	Mechanical vent Extract Fan run on timer linked to light switch
	Exterior Wall Mounted light
	LED Down Light
	1500 long double fluorescent fitting with owner selected diffuser.
	Soffit mounted Exterior Double Spot Light with Sensor
	PDL 600 series white cover plate, white switch, 1000mm high

APPROVED
BC210007
22/02/2021
Andrew Nichols
Page 28 of 34
Central Hawkes Bay
District Council

1) ALL DIMENSIONS TO BE CONFIRMED ON SITE BY CONTRACTOR BEFORE MANUFACTURE / CONSTRUCTION. DO NOT SCALE OFF DRAWINGS. NOTIFY DESIGNER IMMEDIATELY OF ANY DISCREPANCIES.
2) THESE DRAWINGS MUST BE READ IN CONJUNCTION WITH ALL SPECIFICATIONS, ENGINEER & SUB-CONSULTANCE DOCUMENTATION & TRADE RELATED PUBLICATIONS. CONSTRUCT IN ACCORDANCE WITH THE NEW ZEALAND BUILDING CODE & OTHER STATUTORY, REGULATORY DOCUMENTS & TERRITORIAL AUTHORITY REQUIREMENTS.

REV	DATE	AMENDMENT
1	16.12.20	CONSENT ISSUE

pak design


ARCHITECTURAL DESIGNERS

8 Connolly Place, Milson, Palmerston North 4414
P: 06 350 3902 C: 027 204 9423
E: office@pakdesign.co.nz W: www.pakdesign.co.nz
COPYRIGHT © ALL RIGHTS RESERVED


PROJECT:
Tritt Home
Homewood Rd, Wapawa

DRAWING TITLE:
Electrical Layout


DATE:	16-Dec-20	JOB #:	20030
DESIGNED:	MCJ	DRAWN:	MCJ
ISSUE:	Consent	CHECKED:	MCJ
SCALE:	A3 @ 1:100 A1 @ 1:50	DRAWING #:	REV:
		L105	R1

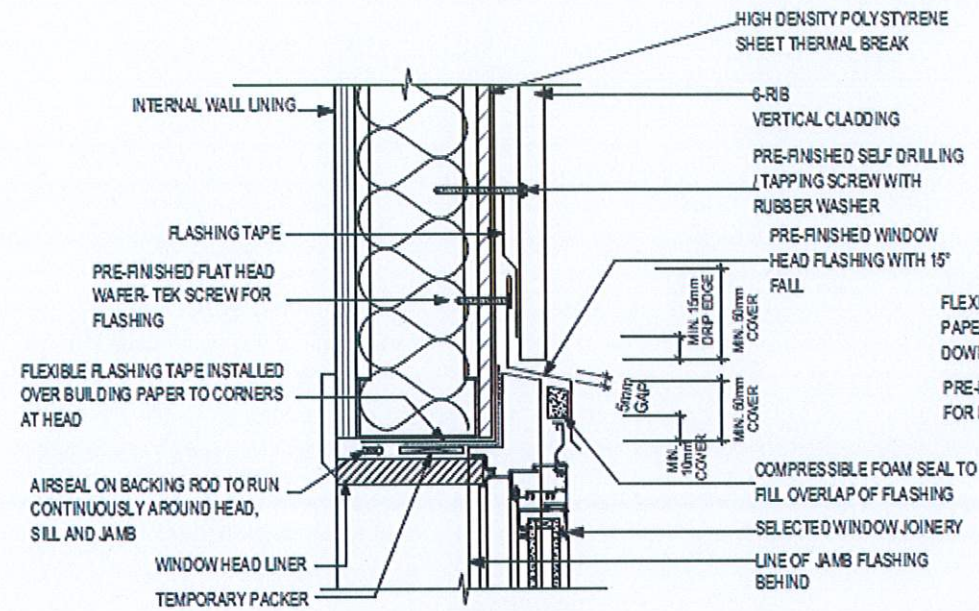


1. Window Head Detail

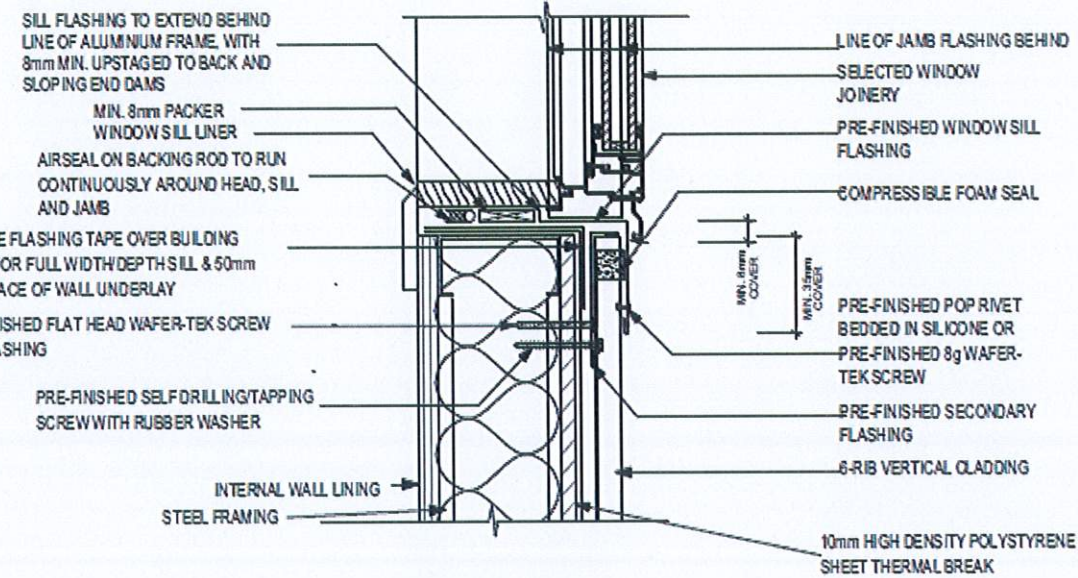

2. Window Sill Detail

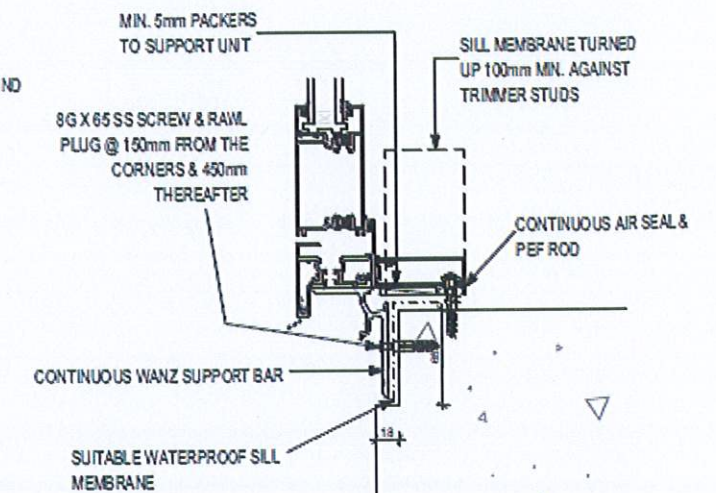


3. Door Sill Detail

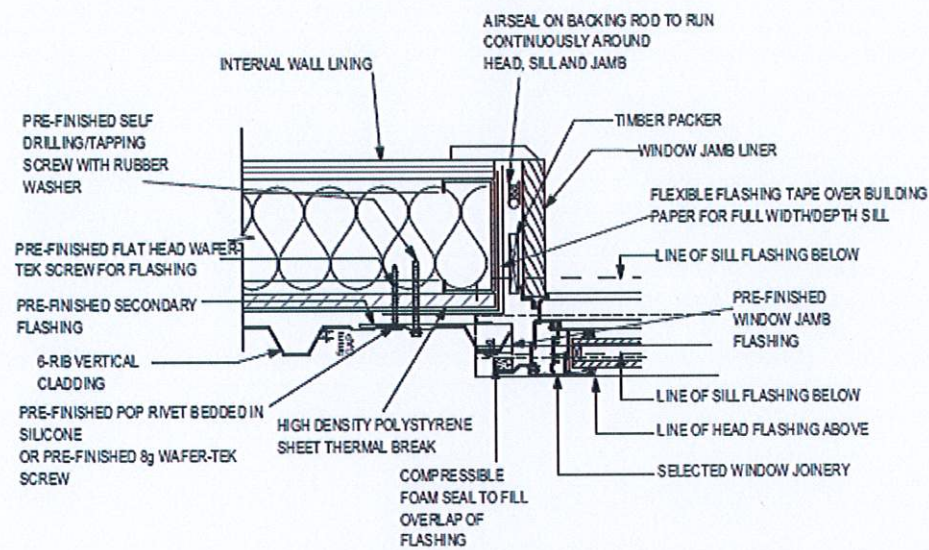

5. Window Jamb Detail

ALL EXTERIOR DOOR SILL REBATE DIMENSIONS SHALL BE CONFIRMED WITH SELECTED JOINERY MANUFACTURER BY CONTRACTOR PRIOR TO CONSTRUCTION.

APPROVED
BC210007
22/02/2021
Andrew Nichols
Page 29 of 34
Central Hawkes Bay
District Council

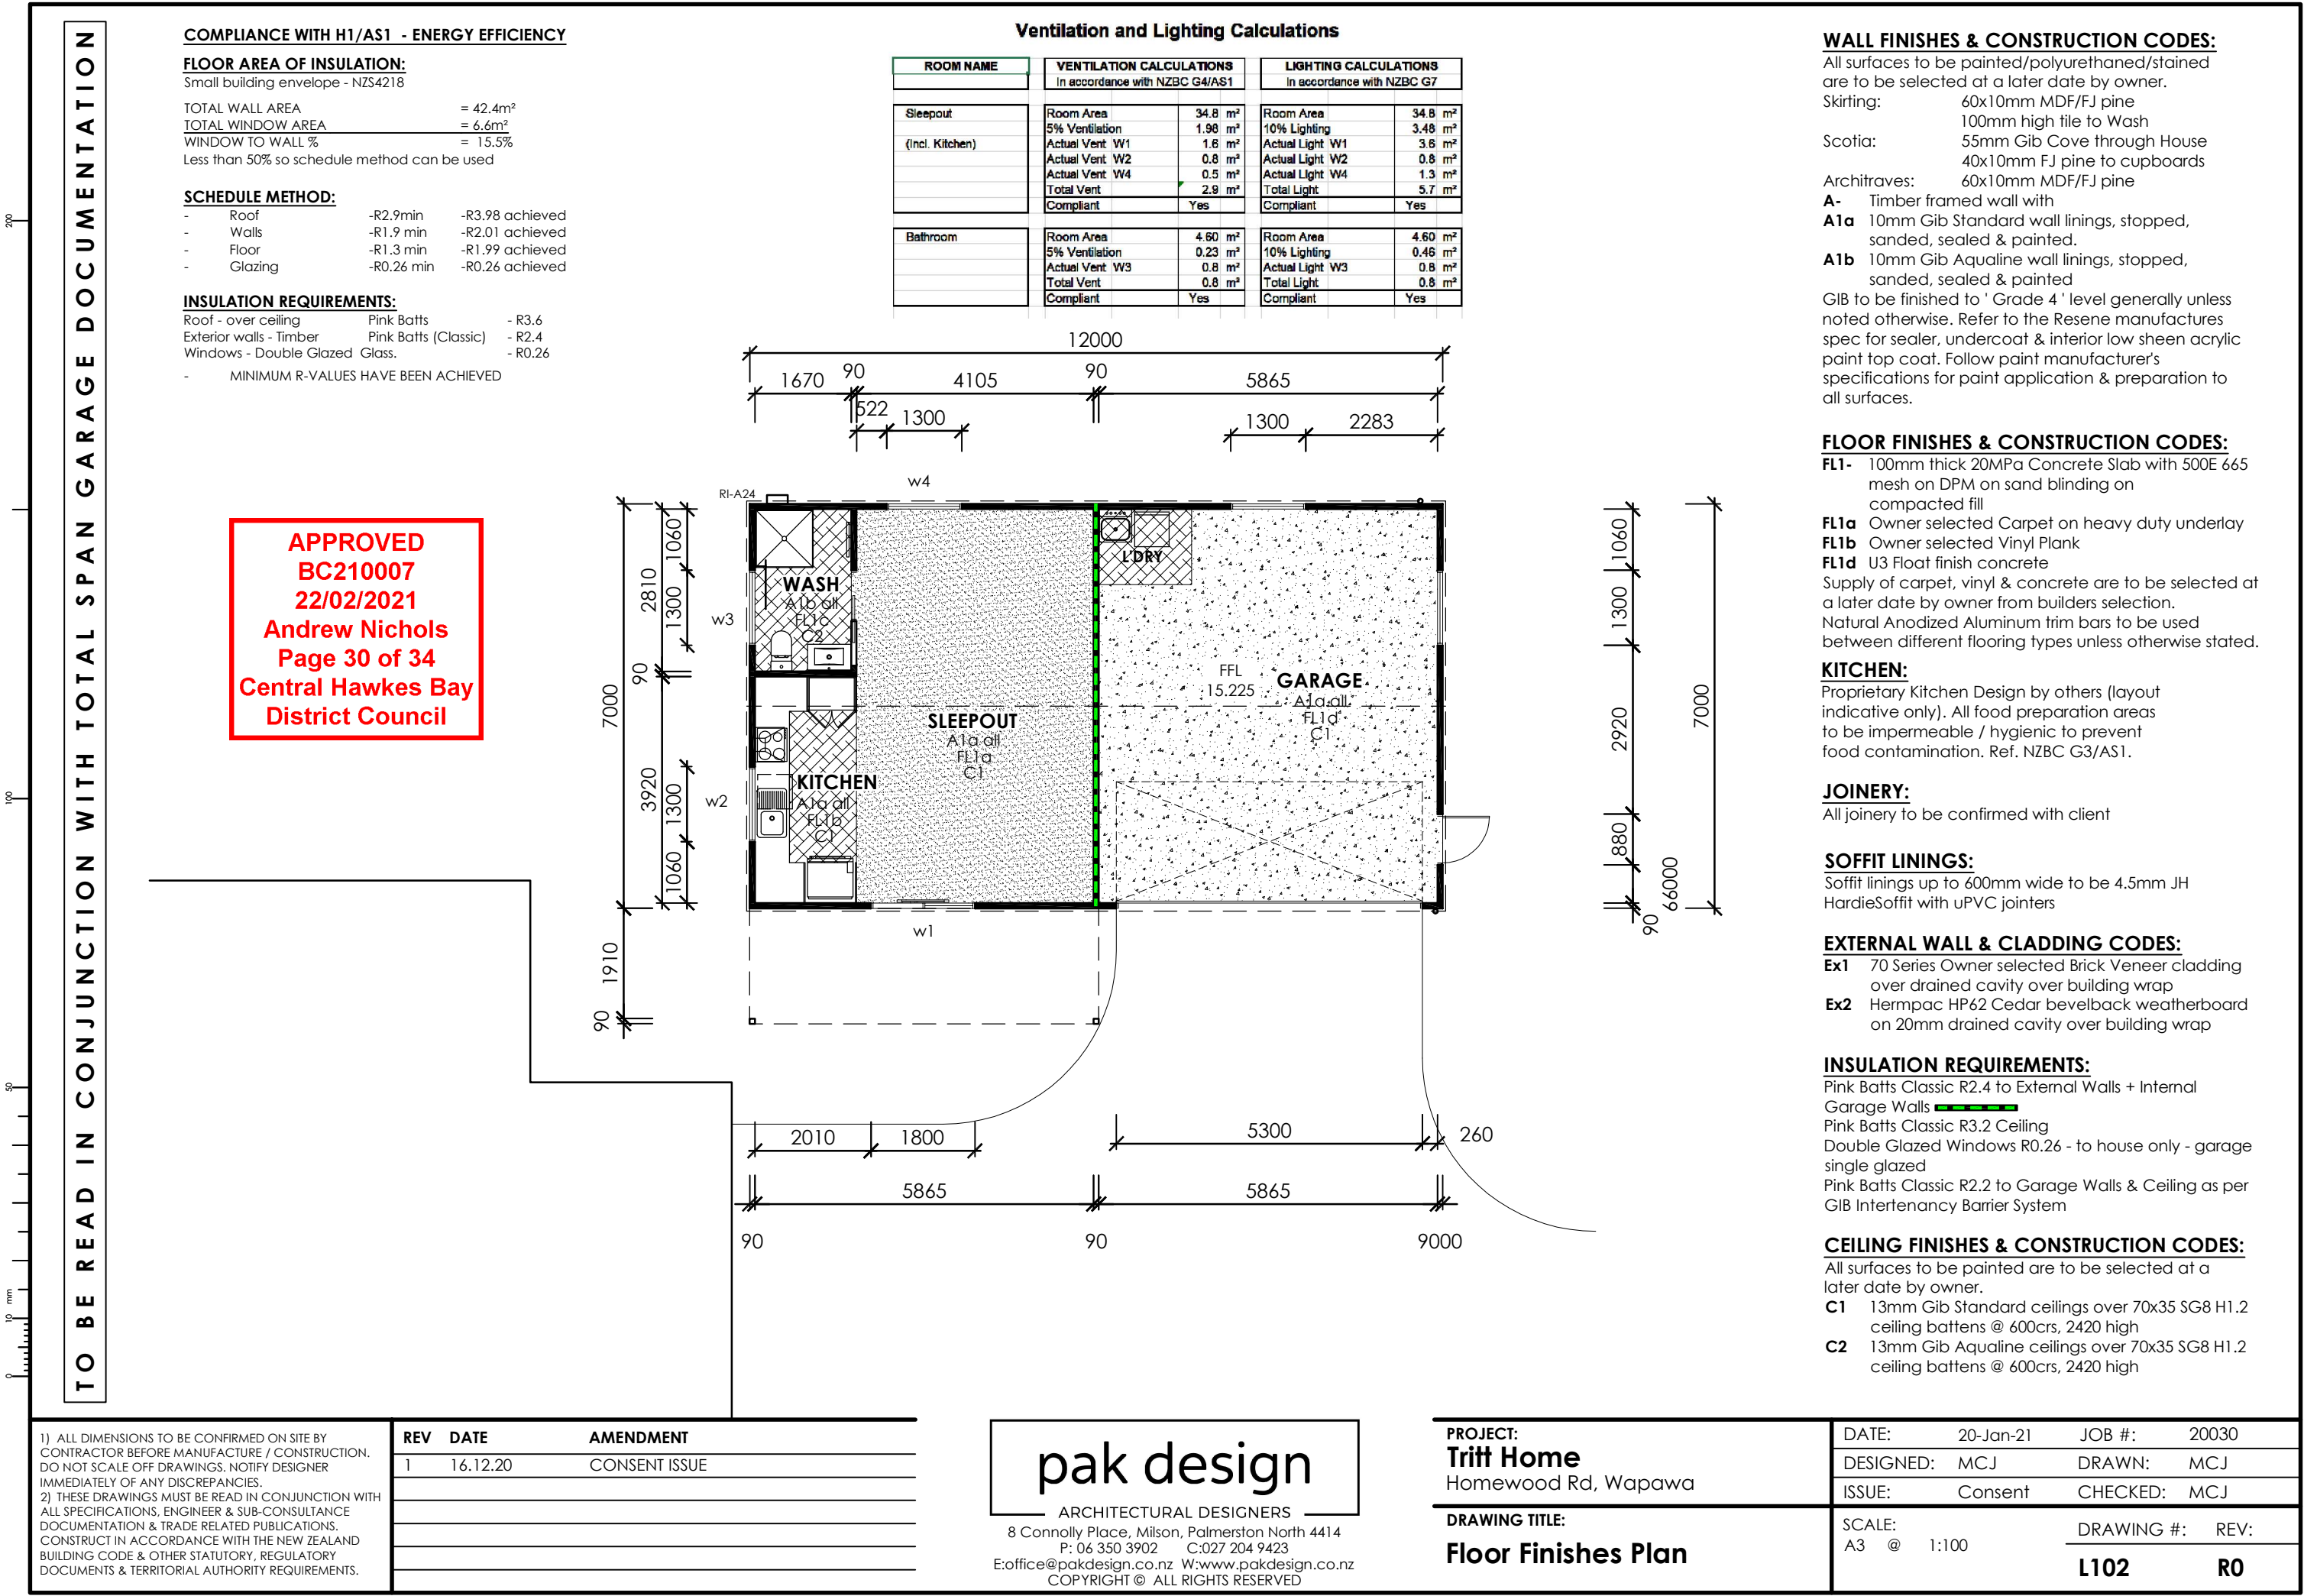

Ventilation and Lighting Calculations

ROOM NAME	VENTILATION CALCULATIONS		LIGHTING CALCULATIONS	
	In accordance with NZBC G4/AS1		In accordance with NZBC G7	
Sleepout (Incl. Kitchen)	Room Area	34.8 m²	Room Area	34.8 m²
	5% Ventilation	1.98 m²	10% Lighting	3.48 m²
	Actual Vent W1	1.8 m²	Actual Light W1	3.8 m²
	Actual Vent W2	0.8 m²	Actual Light W2	0.8 m²
	Actual Vent W4	0.5 m²	Actual Light W4	1.3 m²
	Total Vent	2.9 m²	Total Light	5.7 m²
	Compliant	Yes	Compliant	Yes
Bathroom	Room Area	4.60 m²	Room Area	4.60 m²
	5% Ventilation	0.23 m²	10% Lighting	0.46 m²
	Actual Vent W3	0.8 m²	Actual Light W3	0.8 m²
	Total Vent	0.8 m²	Total Light	0.8 m²
	Compliant	Yes	Compliant	Yes

WALL FINISHES & CONSTRUCTION CODES:

All surfaces to be painted/polyurethaned/stained are to be selected at a later date by owner.
Skirting: 60x10mm MDF/FJ pine
100mm high tile to Wash
Scotia: 55mm Gib Cove through House
40x10mm FJ pine to cupboards
Architraves: 60x10mm MDF/FJ pine
A- Timber framed wall with
A1a 10mm Gib Standard wall linings, stopped, sanded, sealed & painted.
A1b 10mm Gib Aqualine wall linings, stopped, sanded, sealed & painted
GIB to be finished to 'Grade 4' level generally unless noted otherwise. Refer to the Resene manufactures spec for sealer, undercoat & interior low sheen acrylic paint top coat. Follow paint manufacturer's specifications for paint application & preparation to all surfaces.

FLOOR FINISHES & CONSTRUCTION CODES:

FL1- 100mm thick 20MPa Concrete Slab with 500E 665 mesh on DPM on sand blinding on compacted fill
FL1a Owner selected Carpet on heavy duty underlay
FL1b Owner selected Vinyl Plank
FL1d U3 Float finish concrete
Supply of carpet, vinyl & concrete are to be selected at a later date by owner from builders selection.
Natural Anodized Aluminum trim bars to be used between different flooring types unless otherwise stated.

KITCHEN:

Proprietary Kitchen Design by others (layout indicative only). All food preparation areas to be impermeable / hygienic to prevent food contamination. Ref. NZBC G3/AS1.

JOINERY:

All joinery to be confirmed with client

SOFFIT LININGS:

Soffit linings up to 600mm wide to be 4.5mm JH HardieSoffit with uPVC jointers

EXTERNAL WALL & CLADDING CODES:

Ex1 70 Series Owner selected Brick Veneer cladding over drained cavity over building wrap
Ex2 Hermpac HP62 Cedar bevelback weatherboard on 20mm drained cavity over building wrap

INSULATION REQUIREMENTS:

Pink Batts Classic R2.4 to External Walls + Internal Garage Walls
Pink Batts Classic R3.2 Ceiling
Double Glazed Windows R0.26 - to house only - garage single glazed
Pink Batts Classic R2.2 to Garage Walls & Ceiling as per GIB Intertency Barrier System

CEILING FINISHES & CONSTRUCTION CODES:

All surfaces to be painted are to be selected at a later date by owner.
C1 13mm Gib Standard ceilings over 70x35 SG8 H1.2 ceiling battens @ 600crs, 2420 high
C2 13mm Gib Aqualine ceilings over 70x35 SG8 H1.2 ceiling battens @ 600crs, 2420 high

COMPLIANCE WITH H1/AS1 - ENERGY EFFICIENCY

FLOOR AREA OF INSULATION:

Small building envelope - NZS4218

TOTAL WALL AREA = 42.4m²
TOTAL WINDOW AREA = 6.6m²
WINDOW TO WALL % = 15.5%
Less than 50% so schedule method can be used

SCHEDULE METHOD:

- Roof -R2.9min -R3.98 achieved
- Walls -R1.9 min -R2.01 achieved
- Floor -R1.3 min -R1.99 achieved
- Glazing -R0.26 min -R0.26 achieved

INSULATION REQUIREMENTS:

Roof - over ceiling Pink Batts - R3.6
Exterior walls - Timber Pink Batts (Classic) - R2.4
Windows - Double Glazed Glass. - R0.26
- MINIMUM R-VALUES HAVE BEEN ACHIEVED

APPROVED
BC210007
22/02/2021
Andrew Nichols
Page 30 of 34
Central Hawkes Bay
District Council


pak design

ARCHITECTURAL DESIGNERS
8 Connolly Place, Milson, Palmerston North 4414
P: 06 350 3902 C:027 204 9423
E:office@pakdesign.co.nz W:www.pakdesign.co.nz
COPYRIGHT © ALL RIGHTS RESERVED

PROJECT:
Tritt Home
Homewood Rd, Wapawa

DRAWING TITLE:
Floor Finishes Plan

DATE:	20-Jan-21	JOB #:	20030
DESIGNED:	MCJ	DRAWN:	MCJ
ISSUE:	Consent	CHECKED:	MCJ
SCALE:	A3 @ 1:100	DRAWING #:	REV:
		L102	R0

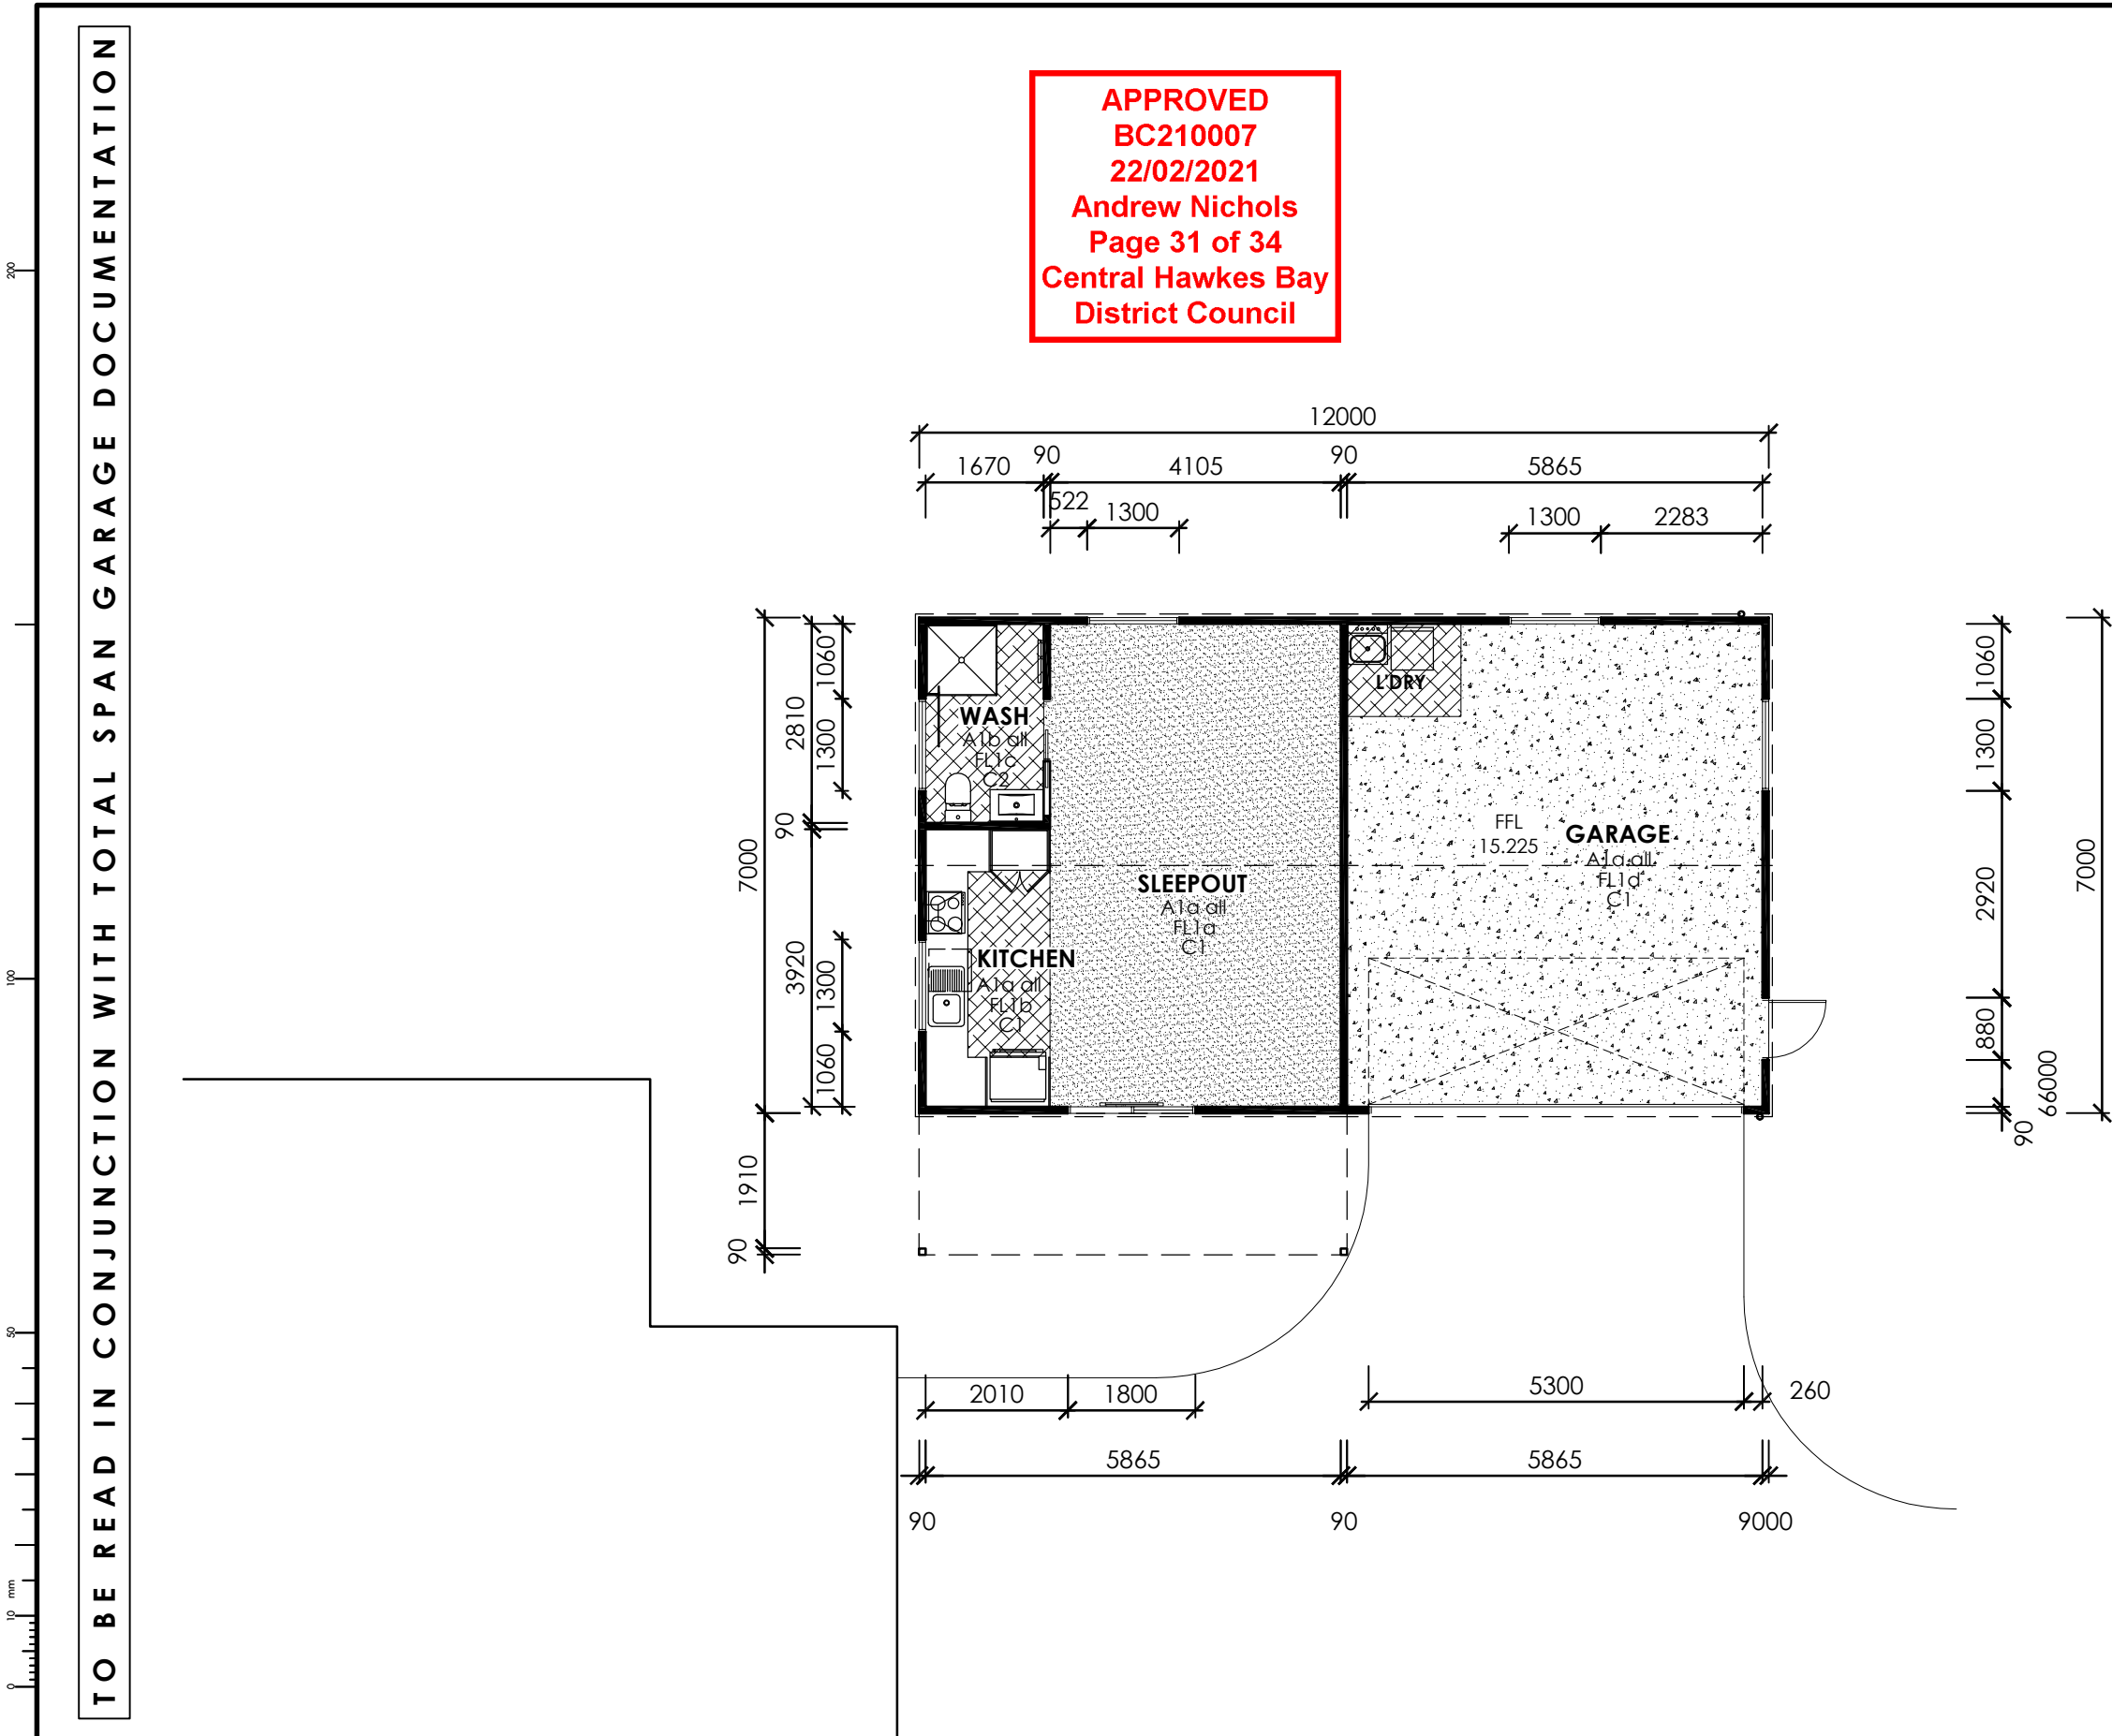

WALL FINISHES & CONSTRUCTION CODES:

All surfaces to be painted/polyurethaned/stained are to be selected at a later date by owner.
Skirting: 60x10mm MDF/FJ pine
100mm high tile to Wash
Scotia: 55mm Gib Cove through House
40x10mm FJ pine to cupboards
Architraves: 60x10mm MDF/FJ pine
A- Timber framed wall with
A1a 10mm Gib Standard wall linings, stopped, sanded, sealed & painted.
A1b 10mm Gib Aqualine wall linings, stopped, sanded, sealed & painted
GIB to be finished to 'Grade 4' level generally unless noted otherwise. Refer to the Resene manufactures spec for sealer, undercoat & interior low sheen acrylic paint top coat. Follow paint manufacturer's specifications for paint application & preparation to all surfaces.

FLOOR FINISHES & CONSTRUCTION CODES:

FL1- 100mm thick 20MPa Concrete Slab with 500E 665 mesh on sand blinding on compacted fill
FL1a Owner selected Carpet on heavy duty underlay
FL1b Owner selected Vinyl Plank
FL1d U3 Float finish concrete
Supply of carpet, vinyl & concrete are to be selected at a later date by owner from builders selection. Natural Anodized Aluminum trim bars to be used between different flooring types unless otherwise stated.

KITCHEN:

Proprietary Kitchen Design by others (layout indicative only). All food preparation areas to be impermeable / hygienic to prevent food contamination. Ref. NZBC G3/AS1.

JOINERY:

All joinery to be confirmed with client

SOFFIT LININGS:

Soffit linings up to 600mm wide to be 4.5mm JH HardieSoffit with uPVC jointers

EXTERNAL WALL & CLADDING CODES:

Ex1 70 Series Owner selected Brick Veneer cladding over drained cavity over building wrap
Ex2 Hermpac HP62 Cedar bevelback weatherboard on 20mm drained cavity over building wrap

INSULATION REQUIREMENTS:

Pink Batts Classic R2.4 to External Walls + Internal Garage Walls
Pink Batts Classic R3.2 Ceiling
Double Glazed Windows R0.26 - to house only - garage single glazed
Pink Batts Classic R2.2 to Garage Walls & Ceiling as per GIB Intertency Barrier System

CEILING FINISHES & CONSTRUCTION CODES:

All surfaces to be painted are to be selected at a later date by owner.
C1 13mm Gib Standard ceilings over 70x35 SG8 H1.2 ceiling battens @ 600crs, 2420 high
C2 13mm Gib Aqualine ceilings over 70x35 SG8 H1.2 ceiling battens @ 600crs, 2420 high

1) ALL DIMENSIONS TO BE CONFIRMED ON SITE BY CONTRACTOR BEFORE MANUFACTURE / CONSTRUCTION. DO NOT SCALE OFF DRAWINGS. NOTIFY DESIGNER IMMEDIATELY OF ANY DISCREPANCIES.
2) THESE DRAWINGS MUST BE READ IN CONJUNCTION WITH ALL SPECIFICATIONS, ENGINEER & SUB-CONSULTANCE DOCUMENTATION & TRADE RELATED PUBLICATIONS. CONSTRUCT IN ACCORDANCE WITH THE NEW ZEALAND BUILDING CODE & OTHER STATUTORY, REGULATORY DOCUMENTS & TERRITORIAL AUTHORITY REQUIREMENTS.

REV	DATE	AMENDMENT
1	16.12.20	CONSENT ISSUE


pak design




ARCHITECTURAL DESIGNERS

8 Connolly Place, Milson, Palmerston North 4414
P: 06 350 3902 C:027 204 9423
E:office@pakdesign.co.nz W:www.pakdesign.co.nz
COPYRIGHT © ALL RIGHTS RESERVED

PROJECT: Tritt Home Homewood Rd, Wapawa	DATE:	16-Dec-20	JOB #:	20030
	DESIGNED:	MCJ	DRAWN:	MCJ
	ISSUE:	Consent	CHECKED:	MCJ
DRAWING TITLE: Floor Finishes Plan	SCALE:	A3 @ 1:100	DRAWING #:	REV:
			L102	R0

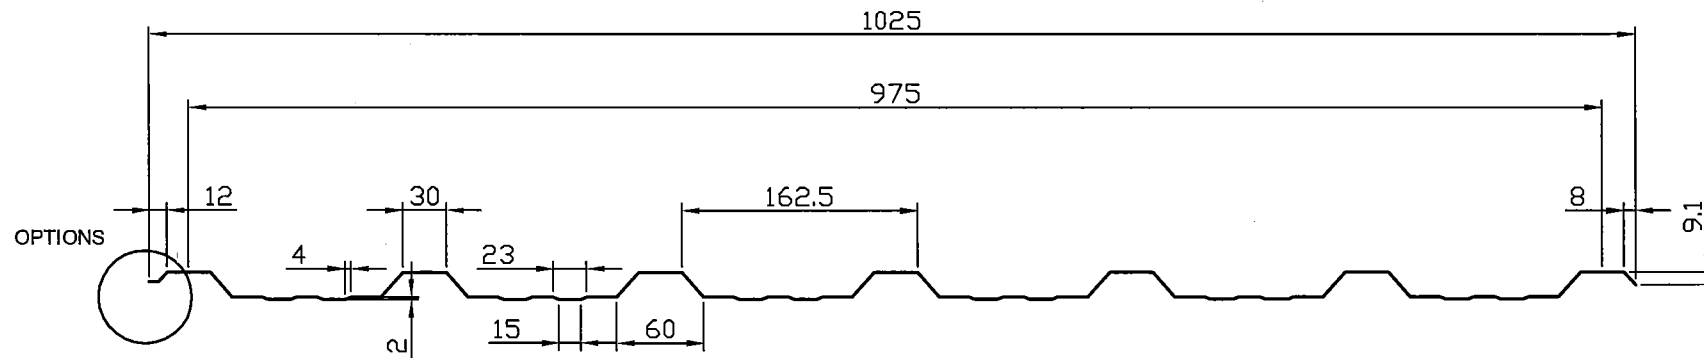DIMENSIONS IN mm UNLESS STATED. THIS IS A C.A.D. DRAWING AND MUST NOT BE ALTERED BY MANUAL METHODS.



- OPTION 1.  FOR PANEL SHED, 301200 & 301225
- OPTION 2.  FOR GARAGE, 301250 & 301300
- OPTION 3.  FOR ALL

APPROVED
BC210007
22/02/2021
Andrew Nichols
Page 32 of 34
Central Hawkes Bay
District Council



VERSATILE BUILDINGS LTD
ENGINEERING DETAILS

74 PLATINUM ST. CRESSYHEAD, QUEENSLAND 4132
 AUSTRALIA (P.O. BOX 2209)
 PH: +61 (07) 3803 4044 FAX: +61 (07) 3803 2380

COPYRIGHT: THESE DRAWINGS MUST NOT BE REPRODUCED
 WITHOUT EXPRESS PERMISSION OF
 VERSATILE BUILDINGS LTD.


MATERIAL DATA				
SLIT	GAUGE	TENSILE	COR.	CODE
1100	0.3	550	ZN	301225
1100	0.35	550	CB	301250
1100	0.35	550	ZN	301300

REVISION	
DESCRIPTION	DATE

DRAWN:	DATE:
PK	08/08/2018
CHECKED:	SCALE:
	1:5

DRAWING TITLE:	
7 RIB	
DRAWING NUMBER:	REVISION:
301225	


Roof Sheeting

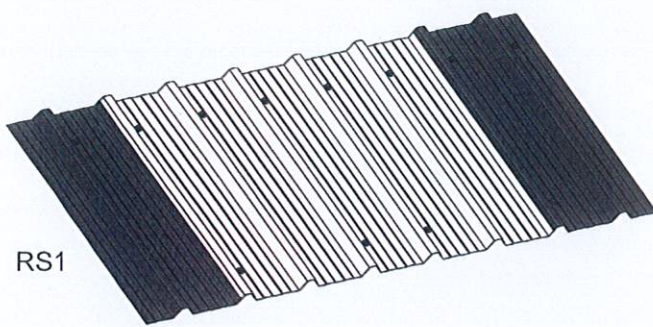

6 Rib

The cladding for roof sheeting shall be fixed using Cladding Hex Tek #12x45 to all purlins, except the ridge purlin, and extend 50mm into the gutter.


On middle purlins tek rib on every join then miss one, place two. On gutter purlin tek every rib.

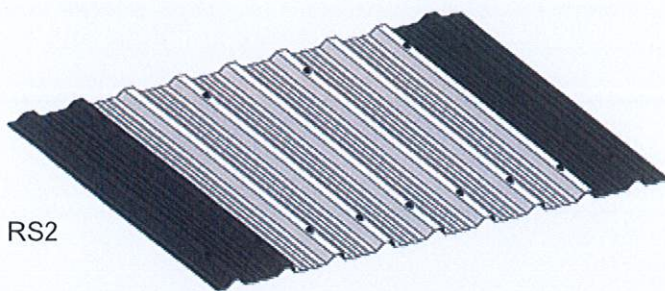

7 Rib

The cladding for roof sheeting shall be fixed with Cladding Hex Tek #12x35 to all purlins, except the ridge purlin, and extend 50mm into the gutter.


On middle purlins tek every second rib. On gutter purlins tek every rib.

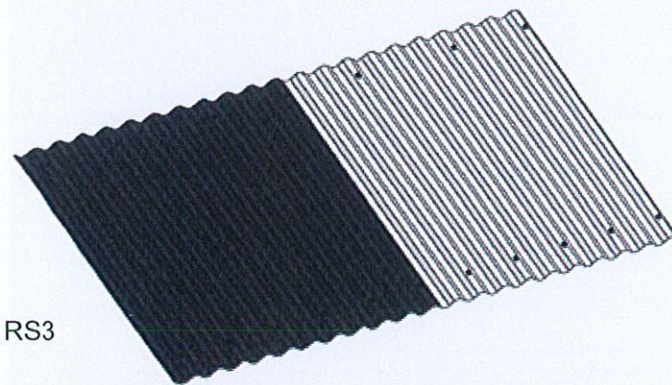

Corrugate

The cladding for roof sheeting shall be fixed with Cladding Hex Tek #12x35 to all purlins, except the ridge purlin, and extend 50mm into the gutter.

On middle purlins tek on rib at every join then miss two, tek one, miss three, tek one. On gutter purlins tek every second rib.

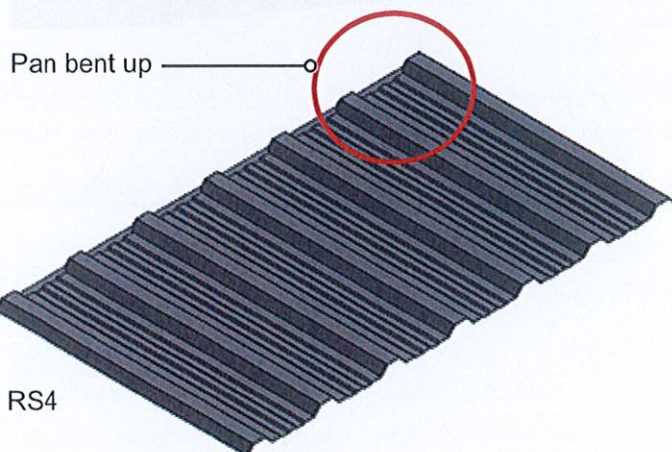


Pan Detail to Ridge

Roof Sheeting to have pans bent up, as shown, to ridge end. Use a crescent if no suitable bending tool is available.

APPROVED
BC210007
22/02/2021
Andrew Nichols
Page 33 of 34
Central Hawkes Bay
District Council



APPROVED
BC210007
22/02/2021
Andrew Nichols
Page 34 of 34
Central Hawkes Bay
District Council

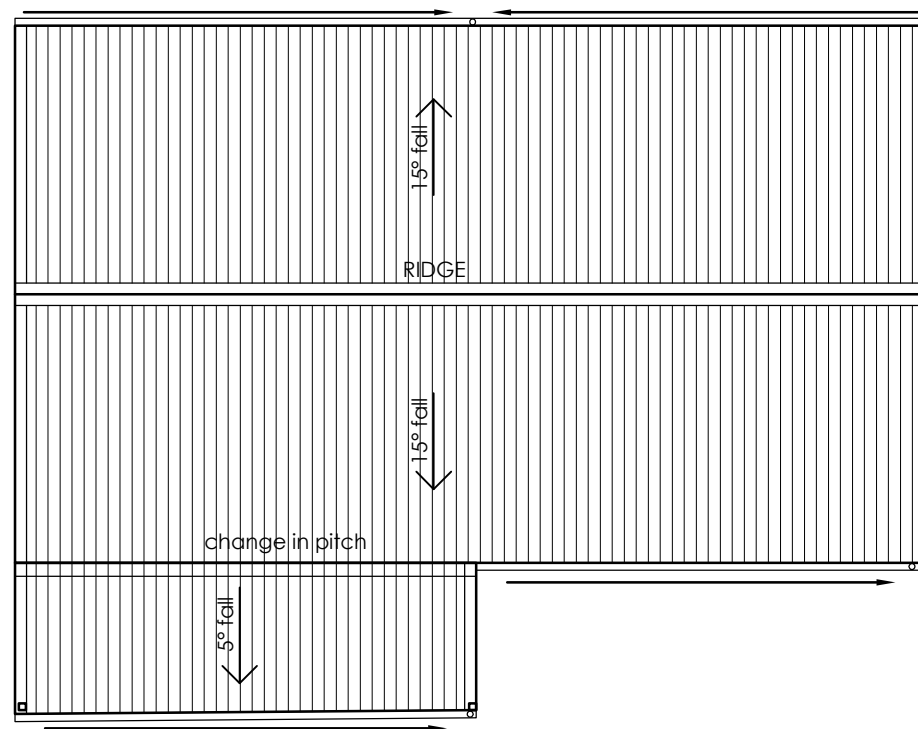

ROOFING NOTES:

1. Fix Roof cladding in accordance with manufacturers specifications, render water tight all flashing at hips, valleys and ridge.
2. All Ridge, Valley, Barge, Eaves & Exposed Apron Flashing to be Colorcote Colorsteel 0.55BMT Unless otherwise stated.
3. Execute and complete all plumbing and drainage requirements in accordance with NZBC E1

 KEY:

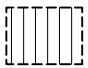-  0.40 BMT Metalcraft T-Rib
Longrun Colorsteel Endura Trapezoidal roofing on
Thermakraft Covertek 407 self-supporting roof underlay
-  1/4 round Profile Colorsteel Continuous
Spouting with External Brackets,
80mm Ø Colorsteel downpipes

ROOF DRAINAGE CALCULATION

DP #	PLAN AREA	AREA TOTAL (m²)	Roof Pitch: 15° Spouting: 125mm 1/4 round profile Roofing: Trapezoidal Rain Fall: 100mm/hr Max Roof Area: 45m2 Down Pipe Size: 80Ø Colorsteel Max Down Pipe Area: 85m2
dp1	43 x 1.13	49	
dp2	22 x 1.13	25	
dp3	33 x 1.13	37	
			ROOF PERIMETER LENGTH - 38m ±

1) ALL DIMENSIONS TO BE CONFIRMED ON SITE BY CONTRACTOR BEFORE MANUFACTURE / CONSTRUCTION. DO NOT SCALE OFF DRAWINGS. NOTIFY DESIGNER IMMEDIATELY OF ANY DISCREPANCIES.
2) THESE DRAWINGS MUST BE READ IN CONJUNCTION WITH ALL SPECIFICATIONS, ENGINEER & SUB-CONSULTANCE DOCUMENTATION & TRADE RELATED PUBLICATIONS. CONSTRUCT IN ACCORDANCE WITH THE NEW ZEALAND BUILDING CODE & OTHER STATUTORY, REGULATORY DOCUMENTS & TERRITORIAL AUTHORITY REQUIREMENTS.

REV	DATE	AMENDMENT
1	16.12.20	CONSENT ISSUE

pak design

ARCHITECTURAL DESIGNERS
8 Connolly Place, Milson, Palmerston North 4414
P: 06 350 3902 C: 027 204 9423
E: office@pakdesign.co.nz W: www.pakdesign.co.nz
COPYRIGHT © ALL RIGHTS RESERVED

PROJECT:
Tritt Home
Homewood Rd, Wapawa

DRAWING TITLE:
Roof Drainage Plan

DATE:	20-Dec-17	JOB #:	20030
DESIGNED:	MCJ	DRAWN:	MCJ
ISSUE:	Consent	CHECKED:	MCJ
SCALE:	DRAWING #: REV:		
A3 @ 1:100			
A1 @ 1:50			
	L104 R1		